


DX 78-1

Barber KANSAS

Section 20 Township 33 Range 11W

Well No. 19 W. A. Newkirk

Company Continental Oil

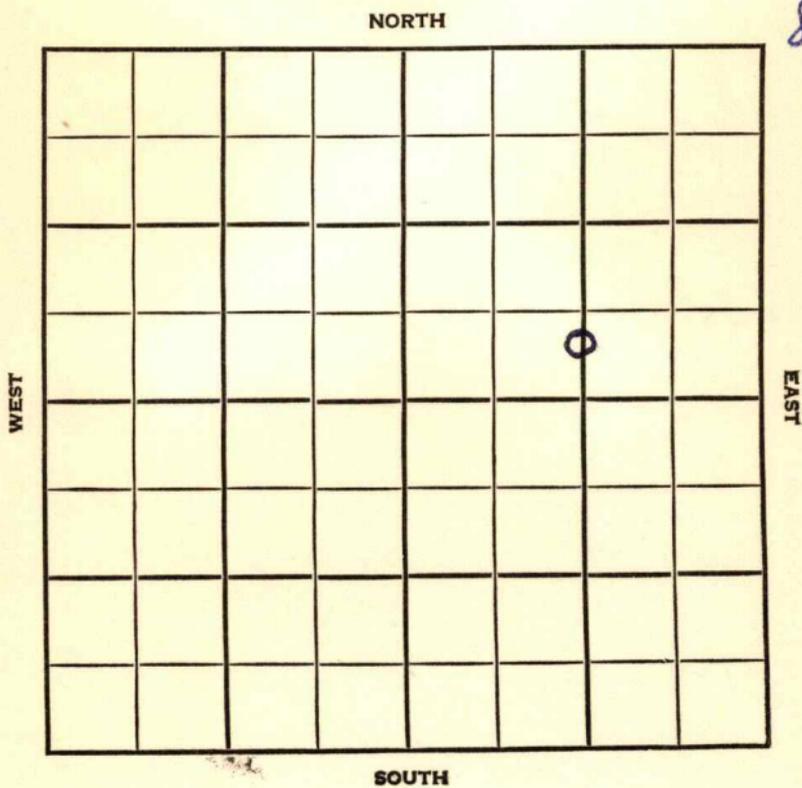

Barber

KANSAS

SEC.	TWP.	R.
20	33	11W

WELL NO. #19 W.A. Newkirk FARM

COMPANY Continental Oil


CONTRACTOR Noble Drlg.

Rhodes Pool
2200 Ft. from N. Line

Ft. from S. Line

1320 Ft. from E. Line

Ft. from W. Line

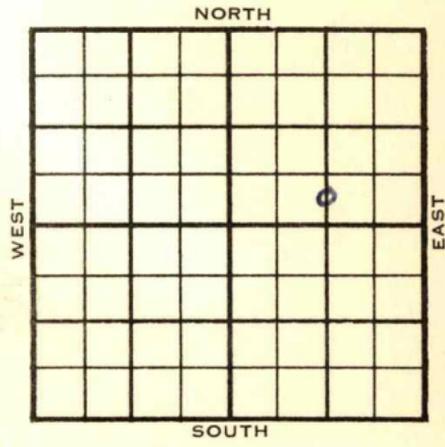

C S $\frac{1}{2}$ S $\frac{1}{2}$ NE

1955	ELEVATION	REPORT
	1381'	

3/23 Location

4/13
 Opud 3-25-55 Oil well TD 4585
 8" @ 264 ^Heeb 3568 Lans 3746
 Miss 4424 TD 4585 5" @ 4584
 CO to 4550 80/4520-40 sd-frac.
 F/102 BO 11 BW 8 hr.
 Comp. F/306 BOPD 33 BW

COMPLETED

