

Section 21 Township 33 Range 11W

Well No. #2 Gilmore

Company Superior Oil

NORTH

14

WEST

EAST


0

SOUTH

Barber **KANSAS**

SEC.	21	TWP.	33	R.	11W
------	----	------	----	----	-----


WELL NO. **2 Gilmore** FARM

COMPANY **Superior Oil**

CONTRACTOR **Field Bros.**

**Rhodes Pool**

\_\_\_\_\_ Ft. from N. Line  
**990** \_\_\_\_\_ Ft. from S. Line  
**330** \_\_\_\_\_ Ft. from E. Line  
 \_\_\_\_\_ Ft. from W. Line

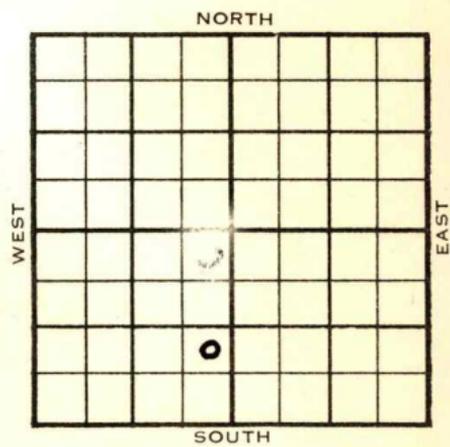

NE SE SW

	ELEVATION	REPORT
1954	<b>1423'</b>	

8/11

R U R

10/20

Spud 8-12-54 Oil well TD 4625  
 10" @ 298 **Anhy 1595 Lans 3795**  
**B KC 4314 Miss 4474** TD 4625  
 7" @ 4625 CO to 4607 104/4579-92  
 1½ BO sd-frac S/15 BOPH 16% wtr.  
 S/24 BF 2 hr. 46% wtr. CO to 4570  
 78/4547-60 frac. F/45 BOPD  
 F/136 BO 24 hr.  
 Comp. F/151 BOPD 4% wtr.

**COMPLETED**



