

Section 21 Township 33 Range 11 WWell No. # 5 GilmoreCompany Superior Oil

NORTH

12

0							

SOUTH

WEST

EAST

SEC.	TWP.	R.
21	33	11W
WELL NO.		
5 Gilmore		FARM
COMPANY		
Superior Oil		
CONTRACTOR		

Peel Bros.


Rhodes Pool

990 Ft. from N. Line

Ft. from S. Line

Ft. from E. Line

330 Ft. from W. Line

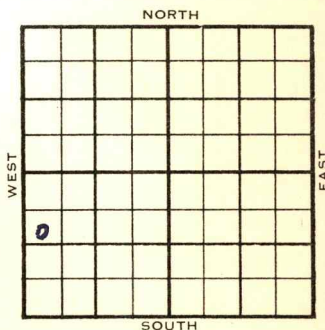

SW NW SW

1954	ELEVATION	REPORT
	1387'	

10/13
12/1

MIR

Spud 10-16-54 Oil well TD 4585
 10-3/4" @ 312 Miss 4438 7" @ 4585
 TD 4585 CO to 4560 176/4520-42
 S/36 BO 24% wtr. 4½ hr. F/15 BO
 11 hr. frac. F/62 BO 20 hr.
 F/65 BO 18 hr. Comp. F/70 BOPD

COMPLETED

County Barber State Kansas

Sec. **21** (Blk. **33** (Sur. **11W** Map No.

Operator **Superior Oil**

Well No. 5 Farm Gilmore

Elev.	Location	SW	NW	SE

0 FIRST REPORT

990 Ft. From N Line SW

330 Ft. From W Line Quarter

1st. Report OCT 13 1954

Completion

Remarks

Peel Bros - Contr.

Spudding Date _____

Drlg. Data Rhodes Pool

M I R

FABEN GILSTRAP

1st. Report

Completion DEC 1 1954

Remarks Rhodes Pool

Peel Bros - Contr.

Spudding Date 10-16-54

Drlg. Data Oil well TD 4585

10 3/4" @ 312 Miss. 4438 7" @ 4585

TD 4585 CO to 4560 176/ 4520-42

S/ 36 bo 24% wtr. $4\frac{1}{2}$ hr. F/ 15 bo 11 hr

frac F/ 62 bo 20 hr. F/ 65 bo 18 hr.

Comp/ F/ 70 bopd

FABEN GILSTRAP