


Section 21 Township 33 Range 11 W

Well No. # 8 Gilmore

Company Superior

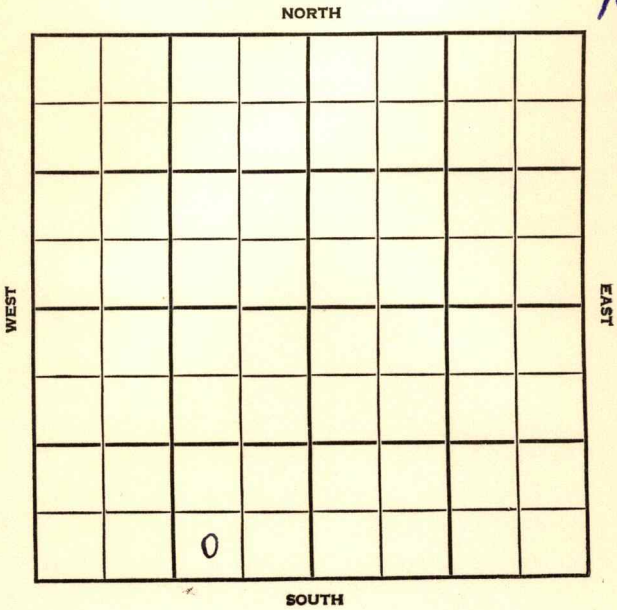

Barber KANSAS

SEC. 21 TWP. 33 R. 11W

WELL NO. 8 Gilmore FARM

COMPANY Superior

CONTRACTOR Peel Bros.


Rhodes Pool

Ft. from N. Line

330 Ft. from S. Line

990 Ft. from E. Line

Ft. from W. Line

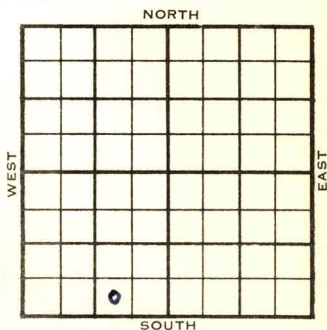

SW SE SW

ELEVATION

REPORT

1954

1377'

11/23

Location

1955

4/6

Abd. Location

ABANDONED



