


Section 21 Township 33 Range 11W

Well No. 4 Page "B"

Company Barbara Oil

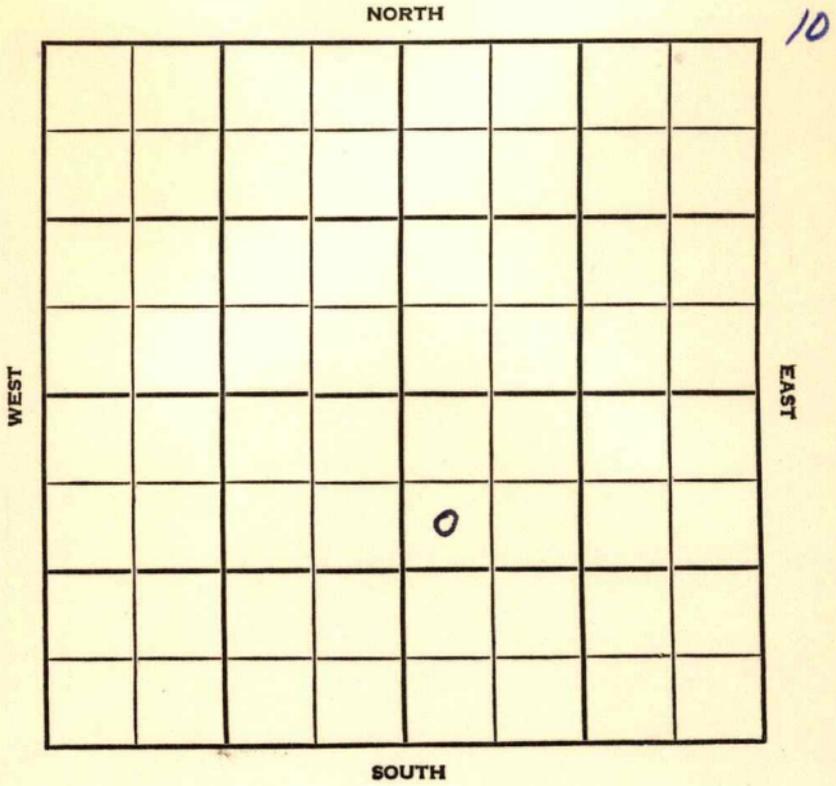

Barber

KANSAS


SEC.	TWP.	R.
21	33	11 W ✓

WELL NO. # 4 Page "B" FARM

COMPANY Barbara Oil

CONTRACTOR Patton Drlg.
Rhodes Pool

990 Ft. from N. Line
 _____ Ft. from S. Line
 _____ Ft. from E. Line
 330 Ft. from W. Line

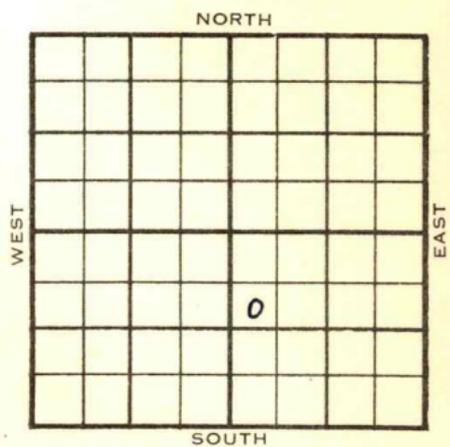

SW NW SE

1954	ELEVATION	REPORT
	1416'	

4/27 Spud 4-18-54
 8" @ 195 Anhy 1685'
 Drlg. 3482'

6/30 Spud 4-18-54 Oil well TD 4620
 8" @ 195 Anhy 1685' Lans. 3794
 Miss. 4470'
 DST 4472-4529 open 1 hr ~~KRE~~
 100,000 CFG, 130' GCM 1720#
 DST 4530-70 open 1 hr rec 30' GCM 85#
 DST 4570-80 open 1 hr rec 150' OCM
 120' MCO 90' wtr. 1370# TD 4620
 7" @ 4620 CO to 4591
 44/4565-76 24/4578-84 FU 350'
 oil 1 hr. F/7 BOPH 1 MCFG.
 F/102 BO 28% wtr. 13 hr.
 Comp. 137 BOPD

COMPLETED

