

Section 21 Township 33 Range 11W

Well No. #9 Page Est. "B"

Company Barbara Oil

NORTH

4

WEST

EAST

0							

SOUTH

Barber

SEC. 21	TWP. 33	R. 11W
------------	------------	-----------


WELL NO. #9 Page Est. "B" FARM

COMPANY Barbara Oil

CONTRACTOR Patton

Rhodes Pool

330 Ft. from N. Line
 Ft. from S. Line
 Ft. from E. Line
 330 Ft. from W. Line

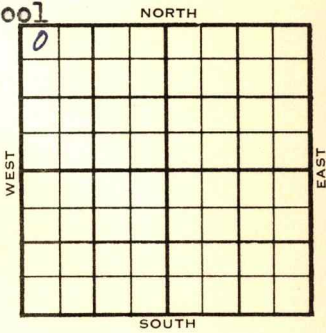

NW NWNW

1954	ELEVATION 1445'	REPORT
------	--------------------	--------

10/20 Spud 10-16-54
 8" @ 216'
 Drlg. 735'

12/8 Spud 10-16-54 Oil well TD 4596
 8" @ 216 Doug. 3726 KC 3782
 Miss. 4495
 DST 4492-4530 open 1 hr gas in 40 min
 rec 100' GCM 849# TD 4596 5" @ 4598
 17/4566-74 SP 4562 60/4550-60
 frac. Comp. F/352 BOPD

COMPLETED

County Barber State Kansas

Sec. 21 (Blk. 33) (Sur. 11W) (Twp.) (Rge.) Map No.

Operator Barbara Oil

Well No. 9 Farm Page Est. "B"

Elev. _____ Location NW NW NW

0					

330 Ft. From N Line NW

330 Ft. From W Line Quarter

1st. Report OCT 20 1954

Completion _____

Remarks _____

Patton - Contr.

Spudding Date 10-16-54

Drlg. Data Rhodes Pool

8" @ 216 drlg. 735

FABEN GILSTRAP

County Barber State Kansas

Sec. 21 (Blk. 33) (Sur. 11W) (Rge.) Map No.

Operator Barbara Oil

Well No. 9 Farm Page Est. "B"

Elev. 1445 Location NW NW NW

0					

330 Ft. From N Line NW

330 Ft. From W Line Quarter

Ist. Report

Completion DEC 8 1954

Remarks Rhodes Pool

Patton - Contr.

Spudding Date 10-16-54

Drlg. Data Oilwell TD 4596

8" @ 216 Doug. 3726 KC 3782

Miss. 4495 DST 4492-4530 open 1 hr.

gas in 40 min. Rec. 100' gcm 849#

TD 4596 5" @ 4598 17/ 4566-74

SP 4562 60/ 4550-60 frac

Comp/ F/ 352 bopd

FABEN GILSTRAP