


SECTION 21 TOWNSHIP 33 RANGE 11W

WELL NO. #11 Page "B"

COMPANY Barbara Oil

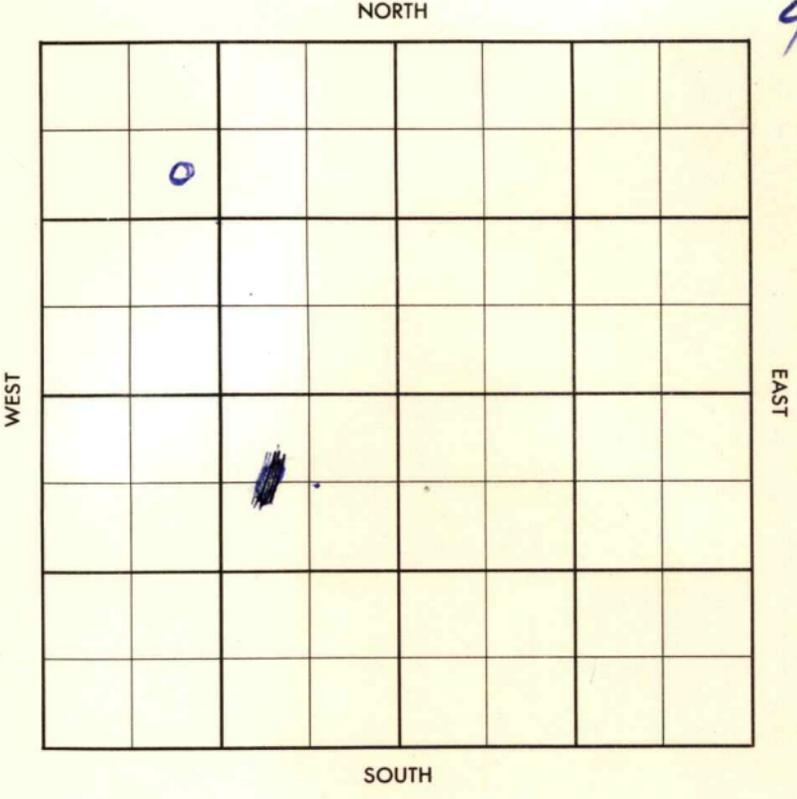

SEC. 21	TWP. 33	R. 11W
-------------------	-------------------	------------------

WELL NO. **#11 Page "B"** FARM

COMPANY **Barbara Oil**

CONTRACTOR **Patton**


Rhoades

_____ FT. FROM N. LINE

_____ FT. FROM S. LINE

_____ FT. FROM E. LINE

_____ FT. FROM W. LINE

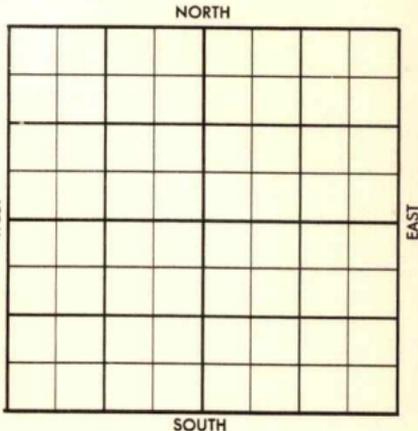

SE NW NW

1956	ELEVATION 1443 RB	REPORT
-------------	-----------------------------	--------

**5-23 8" @ 119 w/175
Drlg. 612**

**7-11 Comm. 5-20-56
DST 4525-85, op 1 hr, rec. 150' HG&SO
CM, 90' HO&GCM, 360' oil, F. 220#, #
IBHP 1600#, FBHP 1200#,
5" @ 4618
CO 4620
Frac 15 x 10
96/ 4543-59, 20/ 4564-69,
FU 500 oil
Flw 887 BOPD / 428 MCFG, 24/64" chk.
BHP 1508#.
M. 4486'
TD 4620'**

COMPLETED

County Barber Elev. _____
 Sec. 21 Twp. 33 Rge. 11W
 Company Barbara Oil
 Farm Name Page "B" No. 11

TOPS	DEPTH	LOG	DATUM	Loc. in Sec.
Anh.				SE NW NW
TP.				
H.				
Tr.				
Dg.				
Bl.				
L.				Geol. _____
K.C.				Contr. _____
B.K.C.				Patton
Ce.				Pool _____
C.				Rhoades
M.				
M.				
K.				
Mz.				
Me.				
V.				
S.				
S.				
A.				
R.				
PE.				
G.				
T.D.				

FIRST REPORT
 MAY 23 '55

Date Comm. 8" @ 119/175 drlg. 612

3002 25 - CA YAM

[Handwritten signature]

P. R.

Co.
Lse.
No.
Sec.
T.
R.

County Barber Elev. 1443 RB
 Sec. 21 Twp. 33 Rge. 11W
 Company Barbara Oil
 Farm Name Page "B" No. 11

TOPS	DEPTH	LOG	DATUM	Loc. in Sec.	
Anh.				SE NW NW	
TP.	
H.	
Tr.	
Dg.	
Bl.	
L.	
K.C.	
B.K.C.				Geol.	
Ce.				Contr.	
C.				Patton	
M.	4486			Pool	
M.				Rhoades	
K.				<table border="1"> <tr><td></td><td></td><td></td><td></td></tr> </table>	
Mz.	
Mo.	
V.	
S.	
S.	
A.	
R.	
PE.	
G.	
T.D.	4620	

COMPLETE

Date Comm. JUL 1 1 1956

8" @ 119/175 drlg. 612 MAY 29 '56

5-20-56 17 2875 JUN 6 '56 D4496

JUN 13 '56

DST: 4525-85, op 1 hr,

Rec. 150 HG 550 CM, 91 HO 360 CM,
360' oil, I 140" F 220, EBHD 1600
FBHP 1200, 5" 4678, Co.

JUN 20 '56

CO 4620 1/2 Frac 15 x 10

JUN 27 '56

96/4543-59 20/4564

-69 FU 500 oil 1/2

JUL 3 '56

21-33-11W SE NW NW

JUL 11 '50

BH Bomb Flw 887

Bord + 428 MCFG.

24/64" ch. BHP 1508#