

Section 21 Township 33 Range 11-W

Well No. #3 Page Est. "B"

Company Barbara Oil

NORTH

2

WEST

EAST

					0		

SOUTH

Barber

KANSAS

Sec. 21 Twp. 33 R. 11W ✓

Well No. #3 Page Est. "B" Farm

Barbara Oil Company

Patton Drlg. -Contr. Contractor

Roads Pool


330' Ft. from N. Line

_____ Ft. from S. Line

_____ Ft. from E. Line

990' Ft. from W. Line

NE NW NE

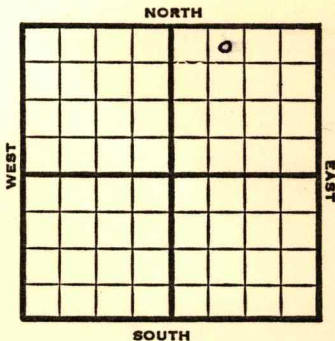

1951 **Elev. 1391'** REPORT

1/10 Spud 1-8-51
10" @ 208'
WOC

2/28 Spud 1-8-51
Oil Well TD 4540
10" @ 208
Miss 4444-4500
7" @ 4498
TD 4540 100 qt/on bottom
Compl 278 bopd

COMPLETED

County Barber State Kansas

Sec. 21 (Blk. 33 (Sur. 11W (Twp. 11W Map No.

Operator Barbara Oil

Well No. 3 Farm Page Est. "B"

Elev. 1391 Location NE NW NE

330 Ft. From N Line NE

990 Ft. From W Line Quarter

1st. Report JAN 1 0 1951

Completion _____

Remarks _____

Patton Drlg. - Contr.

Spudding Date 1-8-51

Drlg. Data Roads Pool

10" @ 208 WCC

County Barber State Kansas

Sec. 21 (Blk. Twp.) 33 (Sur. Rge.) 11W Map No.

Operator Barbara Oil

Well No. 3 Farm Page Est. "B"

Elev. 1391 Location NE NW NE

				0	

330 Ft. From N Line NE

990 Ft. From W Line Quarter

1st. Report

Completion FEB 28 1951

Remarks Roads Pool

Patton Drlg. - Contr.

Spudding Date 1-8-51

Drlg. Data Oil well TD 4540

10" @ 208 Miss. 4444-4500 7" @ 4498

TD 4540 100 qt/ on bottom

Comp. 278 bopd

J. E. TYRA