

A blank 8x8 grid map. The grid is composed of solid black lines forming the outer border and dashed black lines forming the internal divisions. The cardinal directions are labeled: "NORTH" at the top center, "SOUTH" at the bottom center, "WEST" on the left side (rotated 90 degrees counter-clockwise), and "EAST" on the right side (rotated 90 degrees clockwise). The word "Wildcat" is written in a stylized, slightly irregular font at the top left, above the first two columns. A small red circle is drawn in the top right corner, within the first row and seventh column.

Sec. 25 Twp. 33 R. 11-W

Well No. #1 Burne Farm

Bishop Oil Company

Wildcat


330 Ft. from N. Line

_____ Ft. from S. Line

330 Ft. from E. Line

_____ Ft. from W. Line

NE/C

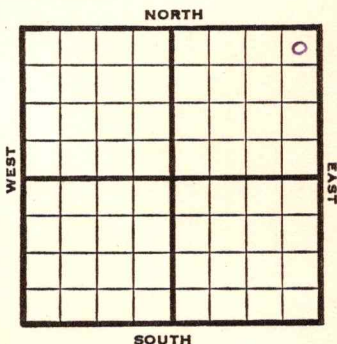

1947 **Elev. 1542'** REPORT

6/18 Location

6/24 Surface hole.

7/1 10" @ 255'
Drlg 2160'

7/8 Drlg. 3462'

7/16 Drlg 4030'

7/22 **Mississippi 4618**
Drlg. 4850

7/30 **Viola 4956'**
Simp. 5033'
Arb. 5214'
TD 5242'

4618	5033
1542	1542
3076	3491

ABANDONED

Map No. _____ Sec. 25 Twp. 33 R. 11W

Well No. 1 Burns

Bishop Oil Company

FIRST REPORT

Contractor _____

NE/C


SECTION PLAT

330 Ft. from N. Line

_____ Ft. from S. Line

330 Ft. from E. Line

_____ Ft. from W. Line

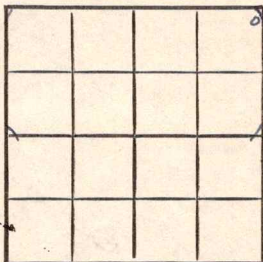

Barber County

Location X

Rig up _____

Drilling and Remarks:

RECORD

Cased _____ in., _____ ft.

~~Sand~~ _____

~~Gas~~ _____

Oil _____

Total Depth _____

PRODUCTION

1st 24 hrs. Nat. _____

1st 24 hrs. after shot _____

Gas _____ Cu. Ft.

Dry Hole _____

Abandoned _____

Date

JUN 18 1947 19

S. J. LEWIS Scout

Map No. 61 Sec. 25 Twp. 33 R. 11W

Well No. 1 Burns

Bishop Oil

Company

ABANDONED

Contractor

NE/C

E1.1542
SECTION PLAT

			d

330 Ft. from N. Line

 Ft. from S. Line

330 Ft. from E. Line

 Ft. from W. Line

Barber County

Location

Rig up

Drilling and Remarks:

Viola 4806
Sing 0223
Art 0214

RECORD

Cased in., ft.

Sand

Gas

Oil

Total Depth 5242

PRODUCTION

1st 24 hrs. Nat.

1st 24 hrs. after shot

Gas Cu. Ft.

Dry Hole

Abandoned

Date

JUL 30 1947 19

S. J. LEWIS

Scout