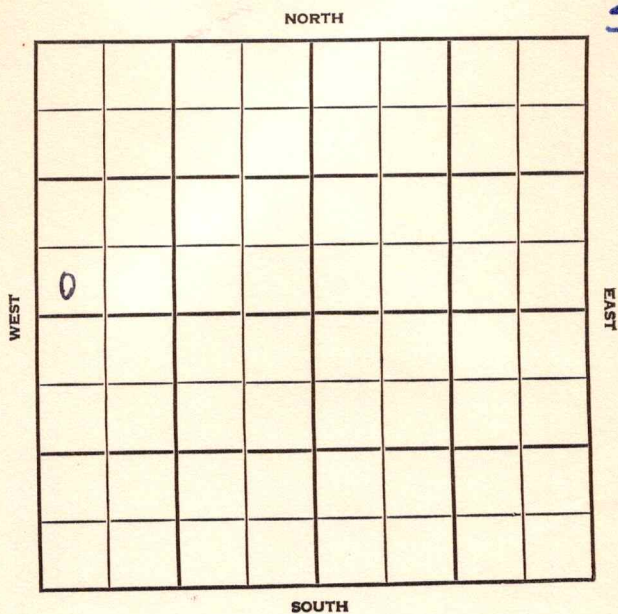


Section 28 Township 33 Range 11 WWell No. # 2 ChapinCompany Superior Oil

Barber

KANSAS

SEC.	28	TWP.	33	R.	11W
------	----	------	----	----	-----

WELL NO.	#2 Chapin	FARM
----------	-----------	------

COMPANY	Superior Oil
---------	--------------

CONTRACTOR	Peel Bros.
------------	------------

Rhodes Pool

Ft. from N. Line

330


Ft. from S. Line

Ft. from E. Line

330

Ft. from W. Line

SW SW NW

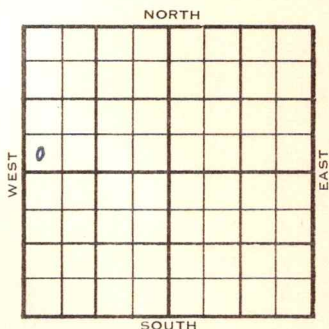

1954	ELEVATION 1370'	REPORT
------	--------------------	--------

12/22 Location

1955

2/23

Spud 1-21-55 Oil well TD 4580

10" @ 316 TD 4580 7" @ 4579

Miss 4442 CO to 4560 96/4524-36

250 M-A sd-oil-frac. F/100 BO 24 hr.

F/72 BO 2% wtr. 18 hr. F/30 BO

8 hr. Comp. 170 BOPD 2% wtr.

COMPLETED

FABEN GILSTRAN

County Barber State KansasSec. 28 (Blk.
Twp.) 33 (Sur.
Rge.) 11W Map No.Operator Superior OilWell No. 2 Farm ChapinElev. 1370 Location SW SW NW330 Ft. From S Line NW330 Ft. From W Line Quarter

1st. Report

Completion FEB 23 1955Remarks Rhodes PoolPeel Bros. - Contr.Spudding Date 1-21-55Drlg. Data Oil well TD 458010" @ 316 TD 4580 7" @ 4579Miss. 4442 CO to 4560 96/ 4524-36250 M-A sd-oil-frac F/ 100 bo 24 hr.F/ 72 bo 2% wtr. 18 hr. F/ 30 bo8 hr. Comp. 170 bopd 2% wtr.

FABEN GILSTRAP