


Section 24 Township 33 Range 11W

Well No. #1 Burns "A"

Company Carl Todd H. L. Hartman

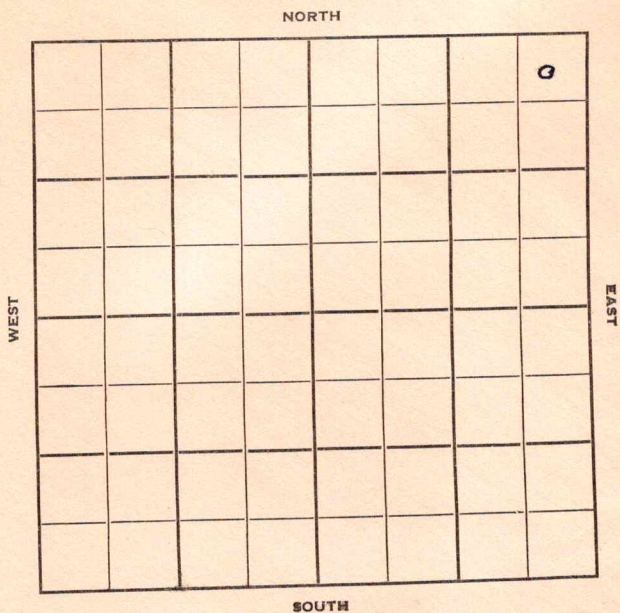

Sec. 24 Twp. 33 R. 11WWell No. #1 Burns "A" Farm~~Carl Todd~~ H. L. Hartman Company

Todd Contractor

Wildcat


330 Ft. from N. Line

Ft. from S. Line

330 Ft. from E. Line

Ft. from W. Line

NE NE NE

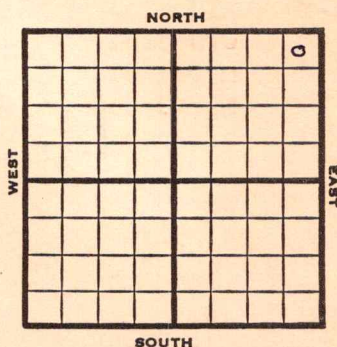1952 **Elev. 1503'** REPORT

11/12 MIM

11/20 Drilling

11/27 **Lans 3855**
Drlg. 4019'

12/4 **Elgin 3508, Heeb. 3639, B-Oread 3687, Doug. 3692, Lans 3855, KC 4147, Miss 4541**
DST 4543-52, opn 1 hr., rec. 15' mud
DST 4553-67, opn 1½ hrs., rec. 500,000 gas, 130' gcm, 1625#
Drlg. 4752'

12/10 Spud 11-12-52
D&A

TD 5161'

10" @ 240

Elgin 3508, Heeb 3639, B. Oread 3687, Doug. 3692, Lans 3855, KC 4147, Miss 4541

DST 4543-52, opn 1 hr., rec. 15' mud

DST 4553-67, opn 1½ hrs., rec. 500,000 gas, 130' gcm, 1625#

Chat 4853, Misener 4881, Sylvian 4886, Viola 4899, Simp 4975, Arb 5136

TD 5161

D&A

ABANDONED

1956

O.W.W.O.

4-18

MIR

OTD 5161'

Marm 4318

Miss. 4540

Misener 4881

V. 4899

S. 4975

A. 5136

7-11

$4\frac{1}{2}$ " @ 4660 w/125

Cal. op $2\frac{1}{2}$ MCFG, 20 min.

152/4540-78,

calc. op Flw 1.220 MCFGPD

TD 5161'

COMPLETED

County **Barber** State **Kansas**Sec. **24** (Blk. Twp.) **33** (Sur. Rge.) **11W** Map No.Operator **Carl Todd**Well No. **1** Farm **Burns "A"**Elev. Location **NE NE NE**

FIRST REPORT

330 Ft. From **N** Line **NE**330 Ft. From **E** Line Quarter1st. Report **NOV 12 1952**

Completion

Remarks **Sun & Superior suppo****Todd - Contr.**

Spudding Date

Drlg. Data

Wildcat**M I M**

J. G. McGEHEE

County Barber State KansasSec. 24 (Blk. 33) (Sur. 11W) (Rge.) Map No.Operator Carl ToddWell No. 1 Farm Burns "A"Elev. 1503 Location NE NE NE

330 Ft. From N Line NE330 Ft. From E Line Quarter

1st. Report

Completion DEC 10 1952Remarks WildcatTodd - Contr.Spudding Date 11-12-52Drlg. Data D & A TD 516110" @ 240 Elgin 3508 Heeb. 3639B. Oread 3687 Doug. 3692 Lans. 3855KC 4147 Miss. 4541 DST 4543-52open 1 hr. Rec. 15' mud DST 4553-67open 1½ hr. Rec. 500,000 gas 130' gcm1625# Chat. 4853 Misener 4881Sylvian 4886 Viola 4899 Simp. 4975Arb. 5136 TD 5161D & A

O.W.W.O.

FORM 513 SUNRAY

OWWO

County Barber Elev. 1503
 Sec. 24 Twp. 33 Rge. 11W
 Company W. L. Hartman (was Carl Todd)
 Farm Name Burns "A" No. 1

Co.

Lse.

No.

Sec.

T.

R.

TOPS	DEPTH	LOG	DATUM
Anh.			
Tr.			
H.			
Tr.			
Dg.			
Bl.			
L.			
K.C.			
B.K.C.			
Ce.			
C. <u>Marm.</u>	<u>4318</u>		
M. <u>iss</u>	<u>4540</u>		
M. <u>Misener</u>	<u>4681</u>		
K.			
Mz.			
Mo.			
V.	<u>4899</u>		
S.			
S.	<u>4975</u>		
A.	<u>5136</u>		
R.			
P.			
G.			
T.D.	<u>5161</u>		

Loc. in Sec. NE NE NE

Geol. H & H

Pool



Date Comm.

M I R

APR 5 9 1028

R.C.

20

0070

County Barber Elev. 1503
 Sec. 24 Twp. 33 Rge. 11W
 Company W. L. Hartman (was Carl Todd)
 Farm Name Burns "A" No. 1

TOPS	DEPTH	LOG	DATUM	Loc. in Sec.
Anh.				NE NE NE
Tr.				
H.				
Tr.				
Dg.				
BL.				
L.				
K.C.				Geol.
B.K.C.				Contr.
Ce.				
C.				H & H
M.				
M.				Pool
K. Misener				Canmena
Mz.				
Ma.				
V.				
S.				
S.				
A.				
R.				
Pe.				
G.				
TD.				

Date Comm. JUL 1 1 1956

M I P APR 25 '56

4 1/2 @ 4660/125

MAY 2 '56 Tite MAY 9 '56 MAY 16 '56 MAY 23 '56

MAY 29 '56 JUN 6 '56 JUN 13 '56 Calc. up 2 1/2 MCF

G. - 20' m (Lugger) JUN 20 '56 Tite

JUN 27 '56 JUL 3 '56 JUL 11 '56 152/4540-78

Calc. up Flw 1,220 MCF GPR