

O.W.W.O

KANSAS

Barber

Section 29 Township 33 Range 11-W


Well No. #1 Cavin

Company Conoco
~~Continental Oil~~

NORTH

5

WEST

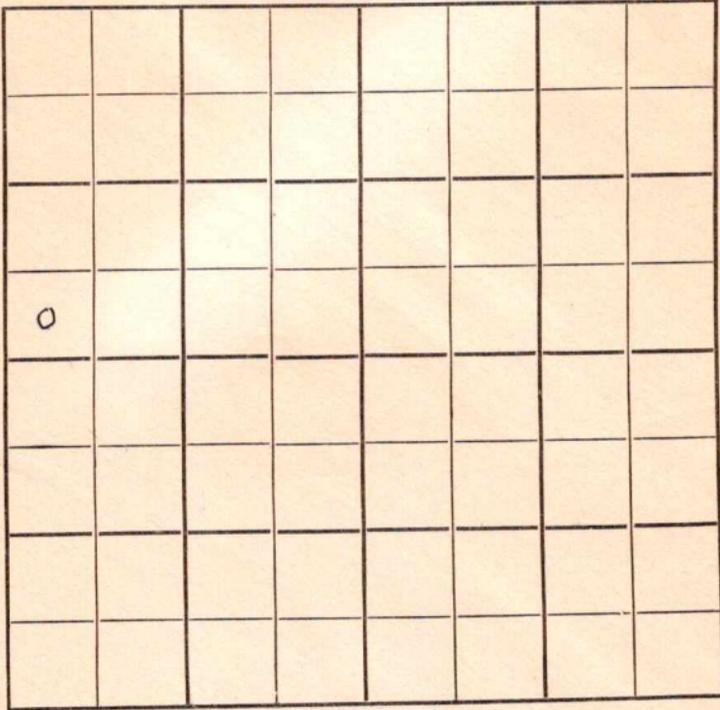

EAST

SOUTH

O.W.W.O.

Barber

KANSAS

Sec. 29 Twp. 33 R. 11W

Well No. #1 Cavin Farm

~~Continental Oil~~ Company

Contractor


Ft. from N. Line

330' Ft. from S. Line

Ft. from E. Line

330' Ft. from W. Line

SW SW NW

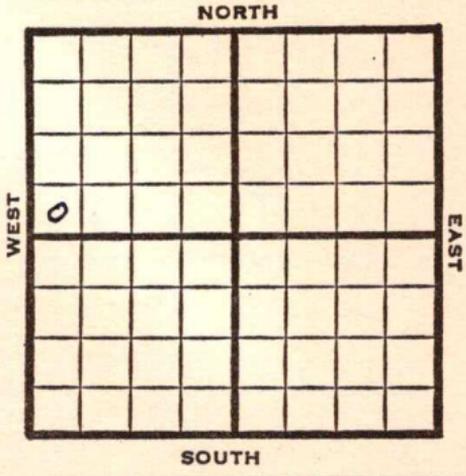

1950

Elev 1418' REPORT

6/28

Rig up Strat Test

11/29

8" @ 90
 Cored 4857-72 rec 7' hd tite sd
 w/thin shale streaks VSSG 3' hd sd w/
 vsso 5' sd
 Cored 4872-80 rec 7' sd sli stain
 DST 4855-80 opn 1 hr rec 715' sw
 S/1 boph
Lans 3833 **Miss 4507**
 SP 4586-91
 DST 4507-30 opn 2 hrs rec 40' gcm SSO
 DST 4530-45 opn 2 hrs rec 60' gcm SSO
 DST 4581-91 opn 1 hr gas in 21 min
 rec 300' hocm
 TD 4591
 7" @ 4583
 DC 4591 S/40 bo 15 hr DD 4592
 S/43 bopd gr 22.8
 DD 4598
 S/28 bo 12 hr DD 4601
 S/8 bo 8 hr DD 4616
 no inc, PB 4595
 S/91 bo 24 hr
 P 14 BO 3 hrs
 P 149 BO 7 hrs
 P 58 BO 5 hrs P 60 BO 7 hrs
 P 46 BO 4 hrs Gv 22.8
 Est 43 bopd WOP
 36 BO PD 6% w
 Completed

OVER

COMPLETED

O.W.W.O.

1953
12/2

KC 3833', Miss 4507'
OTD 4616'
7" @ 4583'
PB 4603' 250 mud acid
Sdfrac w/3000 go 6000#
Sd @ 4570-82
F 160 bo 10 hrs., testing

12/9

Oil Well
TD 4616'
Miss 4507', KC 3833'
OTD 4616'
7" @ 4583'
PB 4603
250 mud acid, sd-frac, 3000 go
6000#
F/160 bo 10 hrs.
Comp. 555 bopd

COMPLETED

Map No. _____ Sec. 29 Twp. 33 R. 11W

Well No. 1 Cavin

_____ Continental Oil _____ Company

_____ Contractor

SW SW NW

SECTION PLAT

o			

FIRST REPORT

_____ Ft. from N. Line

330 Ft. from S. Line

_____ Ft. from E. Line

330 Ft. from W. Line

Barber County

RECORD

Location _____

Rig up X

Drilling and Remarks:

[Handwritten scribbles in the drilling and remarks section]

Cased _____ in., _____ ft.

Sand _____

Gas _____

Oil _____

Total Depth _____

PRODUCTION

1st 24 hrs. Nat. _____

1st 24 hrs. after shot _____

Gas _____ Cu. Ft.

Dry Hole _____

Abandoned _____

Date

JUN 28 1950 19

J. E. TYRA

Scout

County Barber State Kansas

Sec. 29 (Blk.) 33 (Sur.) 11W Map No.

Operator Continental

Well No. 1 Farm Cavin

Elev. 1418 Location SW SW NW

330 Ft. From S Line NW

330 Ft. From W Line Quarter

1st. Report

Completion NOV 29 1950

Remarks Strat test

Spudding Date

COMPLETE

Drlg. Data

8" @ 90 Cored 4857-72 Rec. 7' hd tite sd w/ thin shale streaks VSSG 3' hd sd w/

vsso 5' sd Cored 4872-80 Rec. 7' sd sli stain DST 4855-80 open 1 hr. Rec.

715' sw S/ 1 boph Lans. 3833 Miss. 4507

SP 4586-91 DST 4507-30 open 2 hr. Rec.

40' gcm SSO DST 4530-45 open 2 hr.

Rec. 60' gcm SSO DST 4581-91 open 1 hr.

Gas in 21 min. Rec. 300' hocm TD 4591

7" @ 4583 DC 4591 S/ 40 bo 15 hr.

DD 4592 S/ 43 bopd gr. 22.8 DD 4598

S/ 28 bo 12 hr. DD 4601 S/ 8 bo 8 hr.

DD 4616 no inc. PB 4595 S/ 91 bo 24 hr.

J. E. TYRA

Drig. Data

P14 B0 3 hrs.

P149 B0 7 hrs.

P.58 B0 5 hrs. P60 B0 7 hrs.

P.46 B0 4 hrs. Gr 22.8

461 25

est. 43 BOPD. w.o.p.

NOV 1

NOV 8

NOV 15

NOV 22


NOV 29

36 B0 PPT.

60% W.

DEC 6 1960

DEC 9

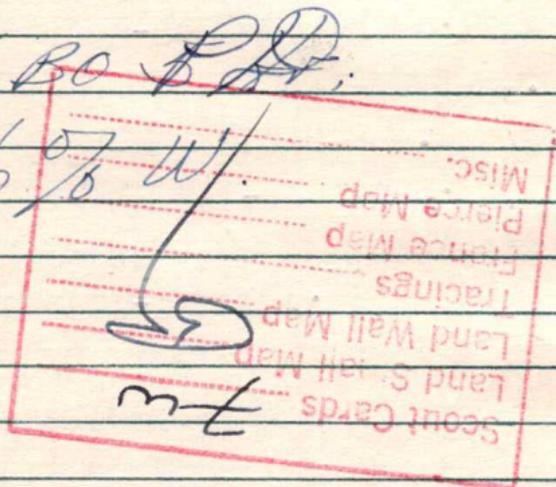

O.W.W.O.

County **Barber** State **Kansas**

Sec. **29** (Blk. Twp.) **33** (Sur. Rge.) **11W** Map No.

Operator **Conoco**

Well No. **1** Farm **Cavin**

Elev. **1418** Location **SW SW NW**

330 Ft. From **S** Line **NW**

330 Ft. From **W** Line **Quarter**

DEC 2 1953

Ist. Report

Completion

Remarks **O.W.W.O.**

Spudding Date **O.W.W.O.**

Drlg. Data

KC 3833 Miss. 4507 OTD 4616 7" @ 4583
PB 4603 250 mud acid sd frac w/ 3000 go
6000# sd @ 4570-82 F/ 160 bo 10 hr.
testing

