


Section 29 Township 33 Range 11W

Well No. 1 Rossell

Company Continental Oil Co.

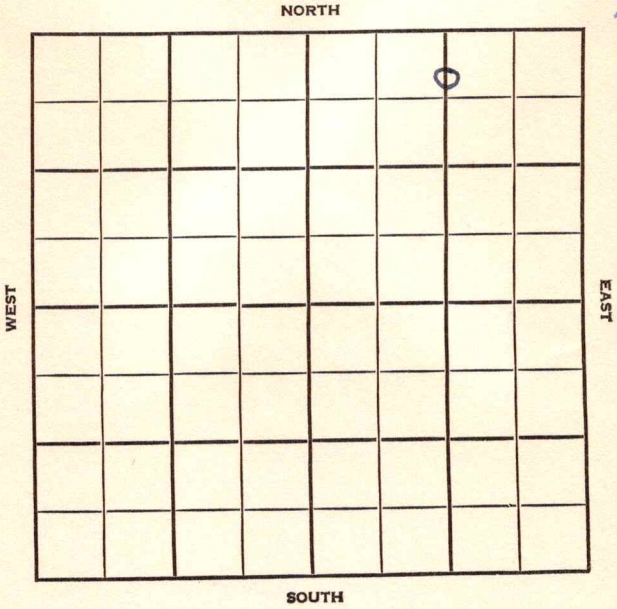

SEC. 29	TWP. 33	R. 11W
------------	------------	-----------

WELL NO. 1 Rossell FARM

COMPANY Continental Oil Co.


CONTRACTOR G.M.R. Tools  
Gerland Pool

440 Ft. from N. Line

Ft. from S. Line

1320 Ft. from E. Line

Ft. from W. Line

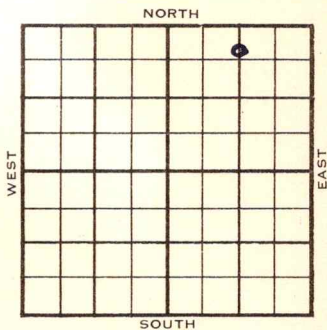

C N/2 N/2 NE

1954	ELEVATION <b>1380'</b>	REPORT
------	---------------------------	--------

9/15 Location  
11/10 Spud 9-21-54  
Oil Well  
TD 4550'  
8-5/8" @ 415'  
**Heeb 3561' Lans 3768' Miss 4449'**  
TD 4550'  
5" @ 4512' 500 A CO to 4550 sd-frac  
F/ 66 bo 6 hr.  
F/ 41 bo 6 hr.  
Comp F/ 160 bopd.

**COMPLETED**



County **Barber** State **Kansas**

Sec. **29** (Blk. Twp.) **33** (Sur. Rge.) **11W** Map No.

Operator **Continental Oil**

Well No. **1** Farm **Rossell**

Elev. **1380** Location **C N $\frac{1}{2}$  N $\frac{1}{2}$  NE**


**440** Ft. From **N** Line **NE**  
**1320** Ft. From **E** Line **Quarter**

1st. Report

**NOV 10 1954**

Completion

Remarks **Gerlane Pool**

**G-M-R - Contr.**

Spudding Date **9-21-54**

Drlg. Data **Oil well TD 4550**

**8 5/8" @ 415 Heeb. 3561 Lans. 3768**

**Miss. 4449 TD 4550 5" @ 4512 500 A**

**CO to 4550 sd-frac F/ 66 bo 6 hr.**

**F/ 41 bo 6 hr. Comp. F/ 160 bopd**

FABEN GILSTRAP