

Barber


DX 78-1

KANSAS

Section 29 Township 33S Range 11W

Well No. #4 K. Rozzell

Company Continental Oil Co.

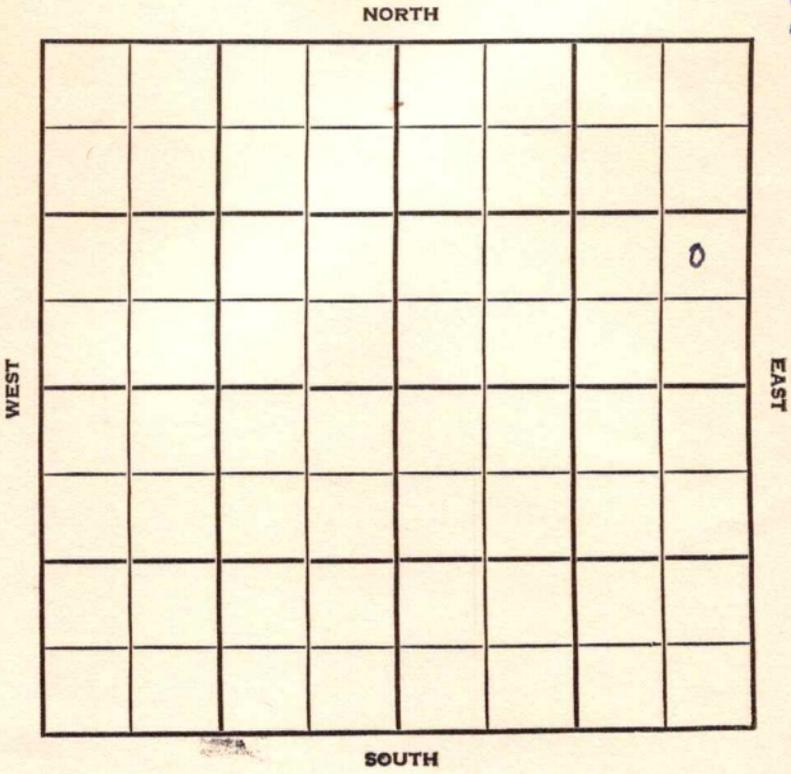

SEC.	TWP.	R.
29	3 3S	11W

WELL NO. **4 K. Rozzell** FARM

COMPANY **Continental Oil Co.**

CONTRACTOR **G-M-R Tools**


Rhodes

_____ Ft. from N. Line

990 _____ Ft. from S. Line

330 _____ Ft. from E. Line

_____ Ft. from W. Line

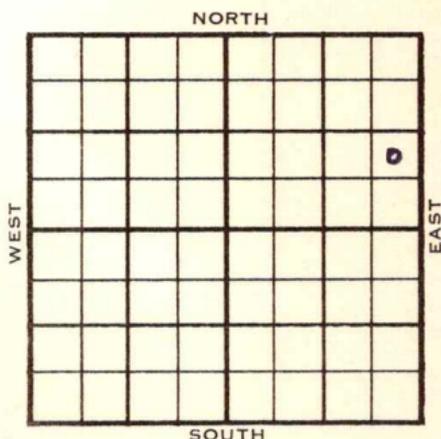

NE SE NE

	ELEVATION	REPORT
1954	1375'	

12/8

Spud 12-2-54
8" @ 267' w/200 sks
rlg. 2936'

12/29

Spud 12-2-54 Oil well TD 4601
8" @ 267' **Leeb 3568 Lans 3740**
Miss 4456

DST 4504-32 open 1 hr rec 34' mud
150# TD 4601 5" @ 4600 CO to 4570
80/4526-46 frac. F/193 BO 8 hr.
Comp. F/579 BOPD

COMPLETED

County **Barber** State **Kansas**

Sec. **29** (Blk. **33S**) (Sur. **11W**) Map No.

Operator **Continental Oil Co.**

Well No. **4** Farm **K. Rozzell**

Elev. Location **NE SE NE**

990 Ft. From **S** Line

330 Ft. From **E** Line **NE** Quarter

1st. Report **DEC 8 1954**

Completion

Remarks **G-M-R tools**

Spudding Date **12-2-54**

Drlg. Data **Rhodes**

8" @ 267 w/200 Drlg 2936

