


Section 34 Township 33 Range 11WWell No. 1 B. C. ForesterCompany Magnolia Petr.

NORTH

4

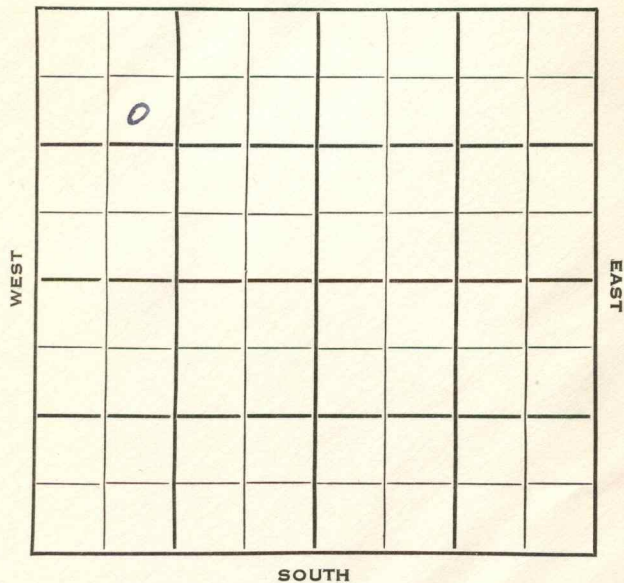

SOUTH

Barber KANSAS

SEC. 34 TWP. 33 R. 11W

WELL NO. 1 B. C. Forester FARM

COMPANY Magnolia Petr.

CONTRACTOR Anschutz Drlg.

S. Roundup Pool

990 Ft. from N. Line


_____ Ft. from S. Line

_____ Ft. from E. Line

990 Ft. from W. Line

SE NW NW

NORTH

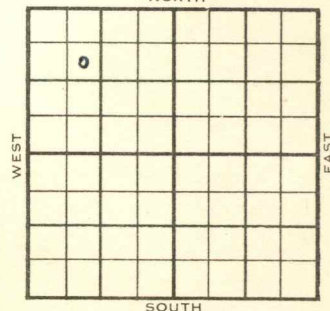

SOUTH

1954

ELEVATION

1384

REPORT

4/7

RUR

8-18

Spdg 4-6-54

Gaswell

TD 4850

10" @ 320

KC 3775 Miss. 4479

DST 4479-4524 open 1 hr. Rec. 95' gcm 1780#

DST 4524-84 open 1 hr. Rec. 40' mud 105#

DST 4588-4652 open 1 hr. Rec. 50' mud 136#

TD 4850

7" @ 4750 CO to 4778 160 /4610-50

frac F/ 16 bo 4 hr. 1 mcfg F/ 70 bf

40% sw 24 hr. PB 4595 PB 4602

120/4560-90 sd-oil-frac F/ 214 bo

45bw 11 hr. F/ 6 bo 147 bsw 24 hr.

PB 4555 72/4524-40 S/ 10 gwph 2 hr.

sd-oil-frac 1000 A F/ 6 bo 6 bwpd

frac 80/4480-4500 sd-oil-frac SI 18 hr

500,000 cfgComp. shut in gas well

COMPLETED

Drig. Data	Gas well	TD 4850
10" @ 320	KC 3775	Miss. 4479
DST 4479-4524	open 1 hr.	Rec. 95' gcm
1780#	DST 4524-84	open 1 hr. Rec. 40'
mud 105#	DST 4588-4652	open 1 hr.
Rec. 50' mud	136#	TD 4850 7" @ 4750
CO to 4778	160/ 4610-50	frac
F/ 16 bo 4 hr..	1 mcfg	F/ 70 bf 40% sw
24 hr.	PB 4595	PB 4602 120/ 4560-90
sd-oil-frac	F/ 214 bo 45 bw	11 hr.
F/ 6 bo	147 bsw	24 hr. PB 4555
72/ 4524-40	S/ 10 gwph	2 hr. sd-oil-frac
1000 A	F/ 6 bo	6 bwpd frac
80/ 4480-4500	sd-oil-frac	SI 18 hr.
500,000 cfr	Comp. shut in	gas well

FABEN GILSTRAP

[illegible]

Orig. Data S. Roundup Pool
RUR

J. G. McGEHEE