

Section 33 Township 33 Range 11WWell No. 1 HarbaughCompany San Diego Oil Co.

NORTH

8

|  |  |  |  |  |  |  |   |
|--|--|--|--|--|--|--|---|
|  |  |  |  |  |  |  |   |
|  |  |  |  |  |  |  |   |
|  |  |  |  |  |  |  |   |
|  |  |  |  |  |  |  | 0 |
|  |  |  |  |  |  |  |   |
|  |  |  |  |  |  |  |   |
|  |  |  |  |  |  |  |   |
|  |  |  |  |  |  |  |   |

SOUTH

WEST

EAST

Barber

KANSAS

|      |      |       |
|------|------|-------|
| SEC. | TWP. | R.    |
| 33   | 33   | 11W ✓ |

WELL NO.

1 Harbaugh

FARM

COMPANY

San Diego Oil Co.

CONTRACTOR

Patton Drlg. Co.


Wildcat

\_\_\_\_\_ Ft. from N. Line

330 \_\_\_\_\_ Ft. from S. Line

330 \_\_\_\_\_ Ft. from E. Line

\_\_\_\_\_ Ft. from W. Line

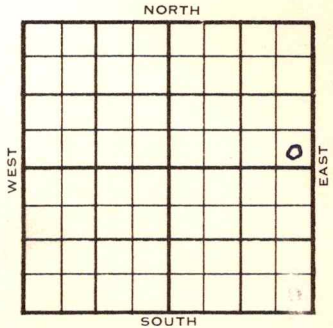

SE SE NE

Mag. &amp; Cont'l support

|       | ELEVATION   | REPORT |
|-------|---|--------|
| 1953  | 1353'   |        |
| 11/11 | Location   |        |
| 11/18 | 8" @ 206' w/200 sks<br>Lans 3751'<br>Drlg 4085'   |        |
| 12/16 | Spud 11-7-53<br>Gas Well<br>TD 5100'<br>8" @ 206'<br>Lans 3751', Miss 4457',<br>DST 4457'-4502' opn 1 hr, gas in 1<br>min, 3,400,000 cfg, rec 30' gcm<br>1765# Viola 4799', Kh. 4646, Meisner<br>4786', Simp 4889', Arb 5078',<br>TD 5100'<br>5" @ 4557'<br>66/ 4453-75 20/ 4475-90 ST 20 hr.<br>3,000,000 gas 1616#<br>Comp. |        |

COMPLETED

J. G. McGEHEE

County Barber State Kansas

Sec. 33 (Blk. Twp.) 33 (Sur. Rge.) 11W Map No.

Operator SanDiego Oil Co.

Well No. 1 Farm Harbaugh

|       |      |          |          |
|-------|------|----------|----------|
| Elev. | 1353 | Location | SE SE NE |
|-------|------|----------|----------|

0

COMPLETE

330 Ft. From S Line NE

330 Ft. From E Line Quarter

1st. Report

Completion **DEC 16 1953**

Remarks Wildcat

Patton Drlg. - Contr.

Spudding Date 11-7-53

|             |          |         |
|-------------|----------|---------|
| Drilg. Data | Gas well | TD 5100 |
|-------------|----------|---------|

8" @ 206    Lans. 3751    Miss. 4457

DST 4457-4502    open 1 hr.    gas in 1 min.

3,400,000 cfb Rec. 30' gcm 1765#

Viola 4799      Kh. 4646      Meisner 4786

Simp. 4889 Arb. 5078 TD 5100 5" @ 4557

66/ 4453-75      20/ 4475-90      SI 20 hr.

3,000,000 gas 1616# Comp.

J. G. McGEHEE