

Barber


DX 78-1

KANSAS

Section 29 Township 33 Range 11W

Well No. #2 Rossell

Company Continental Oil

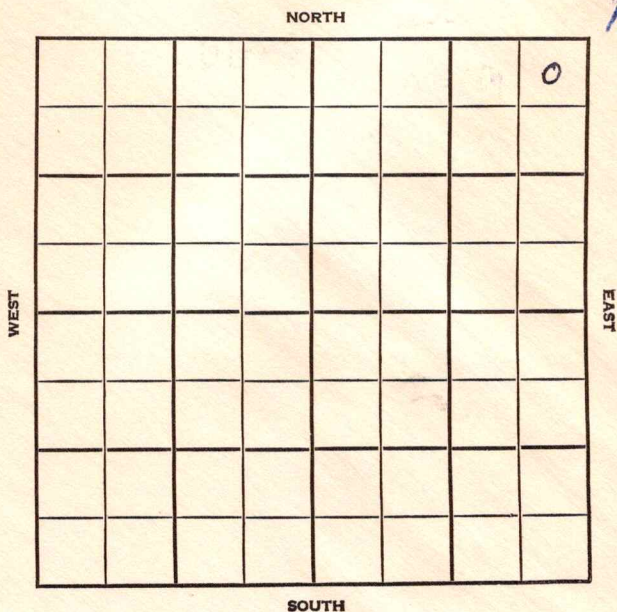

Barber

KANSAS

SEC.	TWP.	R.
29	33	11W

WELL NO.

#2 Rossell

FARM

COMPANY

Continental Oil

CONTRACTOR

G-M-R

Rhodes Pool

NORTH

330

Ft. from N. Line

Ft. from S. Line

330

Ft. from E. Line

Ft. from W. Line

WEST

EAST

							0

SOUTH

NE NE NE

	ELEVATION	REPORT
1954	1373'	

10/27	Spud 10-23-54 8" @ 265' Drlg. 2321'
11/23	Spud 10-23-54 - Oil Well TD 4542' 8" @ 265' Miss 4444' TD 4541' 5" @ 4522' Heeb 3561', Lans 3764', Miss 4443' CO to 4542' sd-oil-frac F/101 bo 9 hrs. Comp. 339 bopd

COMPLETED

FABEN GILSTRAP