

Barber

KANSAS


SECTION 29 TOWNSHIP 33 RANGE 11 W

WELL NO. #14 A. B. Harbaugh

COMPANY Continental Oil

NORTH

14

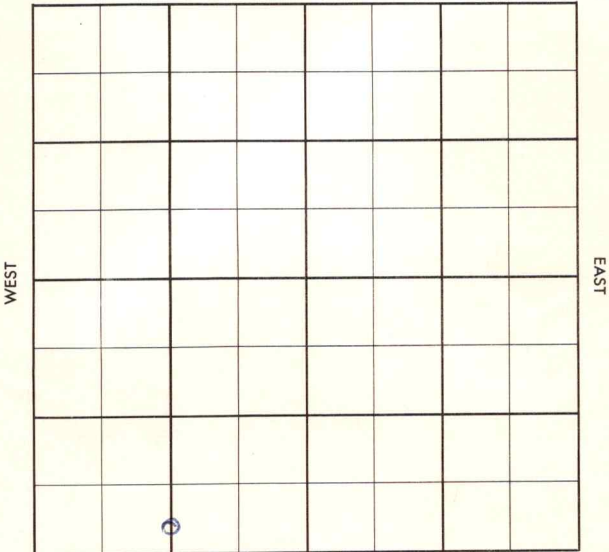

SOUTH

Barber

KANSAS

SEC.

TWP.

R.

29

33

11W

WELL NO.

#14 A. B. Harbaugh

FARM

COMPANY

Continental Oil

CONTRACTOR

Noble

Rhodes


Ft. from N. Line

440

Ft. from S. Line

Ft. from E. Line

Ft. from W. Line

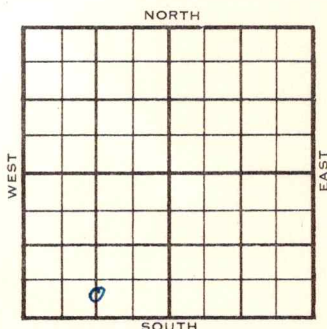C S $\frac{1}{2}$ S $\frac{1}{2}$ SW

1955

ELEVATION

1421

REPORT

10/26

Comm 10-22-55
 8" @ 276 w/225
 Drlg 2020

12-7

5 $\frac{1}{2}$ " @ 4650
 CO. to 4633
 52/ 4613-26, 80/ 4580-4600, 48/ 4556-
 68, 56/ 4535-49,frac
 F/ 68 bo, 6 bw 24 hrs.
 Comp. F/ 58 bopd 4 bw.
 Log tops:

H. 3632

L. 3820

M. 4514

TD 4652

COMPLETED

County Barber Elev. _____ Co.
 Sec. 29 Twp. 33 Rge. 11W
 Company Continental Oil
 Farm Name A. B. Harbaugh No. 14

TOPS	DEPTH	LOG	DATUM
Anh.			
Tp.			
H.			
Tr.			
Dg.			
BL.			
L.			
K.C.			
B.K.C.			
Ce.			
C.			
M.			
M.			
K.			
Mz.			
Ma.			
V.			
S.			
S.			
A.			
R.			
Pe.			
G.			
T.D.			

Loc. in Sec. _____

C S $\frac{1}{2}$ S $\frac{1}{2}$ SW

440' SL

Geol. _____

Contr. _____

Noble

Pool _____

Rhodes

FIRST REPORT
 OCT 26 '55

Date Comm. 10-22-55

8" @ 276/225 drlg. 2020

Co.

Lse.

No.

Sec.

T.

R.

County Barber Elev. 1121
 Sec. 29 Twp. 33 Rge. 11W
 Company Continental Oil
 Farm Name A. B. Harbaugh No. 11

TOPS	DEPTH	LOG	DATUM
Anh.			
Tp.			
H.		3632	2211
Tr.			
Dg.			
BL.			
L.		3820	2399
K.C.			
B.K.C.			
Ce.			
C.			
M.		4514	3093
M.			
K.			
Mz.			
Mq.			
V.			
S.			
S.			
A.			
R.			
Pe.			
G.			
T.D.	4652		

Loc. in Sec.

C S $\frac{1}{2}$ S $\frac{1}{2}$ SW

440' SL

Geol.

Contr.

Noble

Pool

Rhodes

COMPLETED

Date Comm. 10-22-55

DEC 7 1955

8" @ 276/225 5 $\frac{1}{2}$ " @ 4650 CO to 4633

52/ 4613-26 80/ 4580-4600 48/ 4556-68

56/ 4535-49 frac F/ 68 bo 6bw 24 hr

Comp. F/ 58 bopd 4 bw