


Section 29 Township 33 Range ~~11~~ 11W

Well No. 1 U. B. Harbaugh

Company Continental Oil

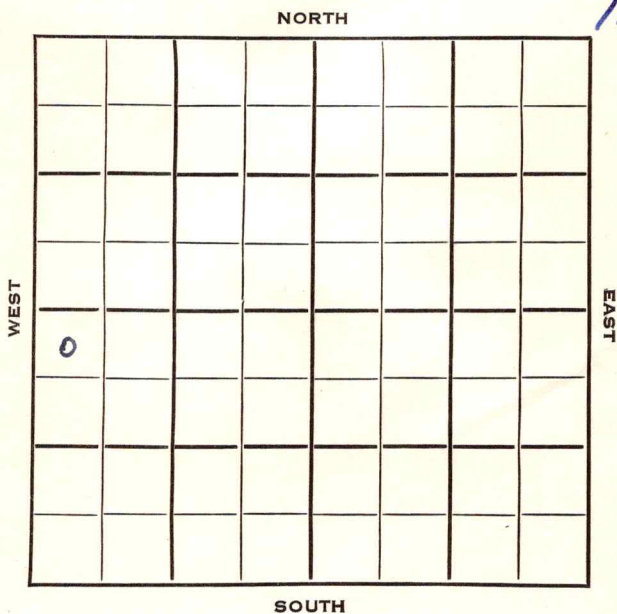

SEC.	TWP.	R.
29	33	11W ✓

WELL NO.

1 U. B. Harbaugh

FARM

COMPANY

Continental Oil

CONTRACTOR

Lohman & Johnson


Gerlane Pool

330 Ft. from N. Line

Ft. from S. Line

Ft. from E. Line

330 Ft. from W. Line

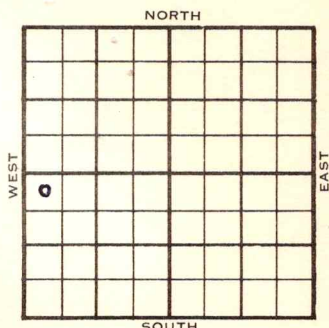

NW NW SW

1954

ELEVATION

REPORT

412'

1/27 Spud 1-23-54
8" @600'
Drlg. 1744'

2/3 Heeb 3609'
Drlg 3734'

2/10 Lans 3808', Cong 4499', Miss 4510',
DST 4510'-4565' 1 hr, 35' M
465#
Drlg.

2/17 DST 4570'-85' 1 hr, 7' M 60#
RTD 4612'
5" @ 4569'
CO 4612'
500 A sd-frac F oil

2/24 F 299 BO 20 hrs.

OVER

1954
3/31

Spud 1-23-54 Oil well TD 4612

8" @ 600 Heeb 3609 Lans 3808

Cong. 4499 Miss 4510

DST 4510-65 open 1 hr. rec 35' mud.
465#

DST 4570-85 open 1 hr rec 7' mud 60#


TD 4612 5" @ 4569 CO to 4585

500 A Sd-frac. F/oil F/299 BO

20 hr. F/108 BO 9 hr.

Comp. 353 BOPD

COMPLETED

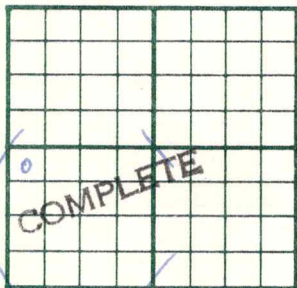County Barber State KansasSec. 29 (Blk.) 33 (Sur.) 11W Map No.Operator Continental OilWell No. 1 Farm U. B. HarbaughElev. 1412 Location NW NW SW330 Ft. From N Line SW330 Ft. From W Line Quarter1st. ReportCompletion MAR 31 1954Remarks Gerlane PoolLohman & Johnson -Contr.Spudding Date 1-23-54Drlg. Data Oil well TD 46128" @ 600 Heeb. 3609 Lans. 3808Cong. 4499 Miss. 4510 DST 4510-65open 1 hr. Rec. 35' mud 465#DST 4570-85 open 1 hr. Rec. 7' mud60# TD 4612 5" @ 4569 CO to 4585500 A sd-frac F/ oil F/ 299 bo 20 hr.F/ 108 bo 9 hr. Comp. 353 bopd

8" @ 600 drlg. 1744

The Cont #1 Harbaugh memo
29-33-11W should have Barber
Co. on first report ticket instead
of Barton Co.

Thanks
J. C.