


Section 29 Township 33 Range 11 W

Well No. # 2 U. B. Harbaugh

Company Continental Oil

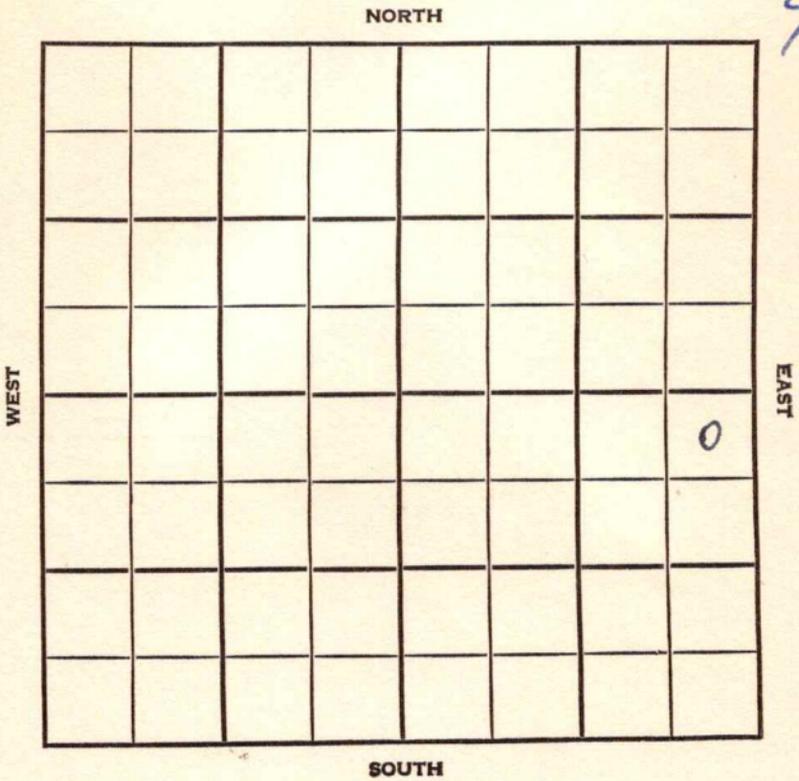

Barber

KANSAS

SEC. 29	TWP. 33	R. 11W
------------	------------	-----------

WELL NO. #2 U.B. Harbaugh FARM

COMPANY Continental Oil

CONTRACTOR G-M-R


Rhodes Pool

330 Ft. from N. Line

Ft. from S. Line

330 Ft. from E. Line

Ft. from W. Line

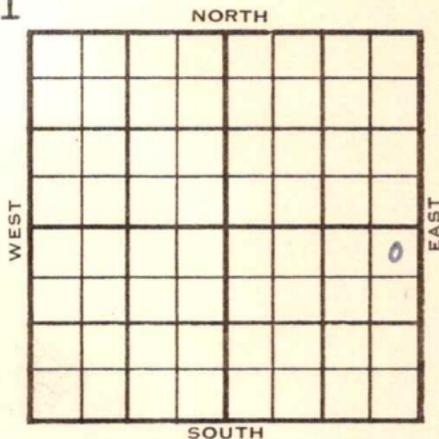

NE NE SE

	ELEVATION	REPORT
1955	1374'	

2/9

Spud 2-8-55

Drlg. 194'

3/2

Spud 2-8-55 Oil well TD 4610'

8" @ 264 Elgin sd 3448'

DST 3370-3475 open 1 hr rec 1650' MSW

1300# TD 4610' 5" @ 4610

Schl tops: Elgin 3446 B. Elgin 3470'

Heeb 3576 Lans 3764 Miss 4453'

CO to 4584' 80/4540-60 sd-frac

F/68 BO 1 BW 8 hr.

Comp. 604 BOPD 3 BW

COMPLETED

