

Barber

**KANSAS**

SECTION 32 TOWNSHIP 33 RANGE 11 W

WELL NO. #15 U. B. Harbaugh

COMPANY Continental

NORTH

6

		0					

WEST

EAST

SOUTH

Barber

KANSAS

SEC.	TWP.	R.
32	33	11W

WELL NO. #15 U. B. Harbaugh FARM

COMPANY Continental

CONTRACTOR Noble Rhoades


\_\_\_\_\_ Ft. from N. Line

\_\_\_\_\_ Ft. from S. Line

\_\_\_\_\_ Ft. from E. Line

\_\_\_\_\_ Ft. from W. Line

SW SE NW

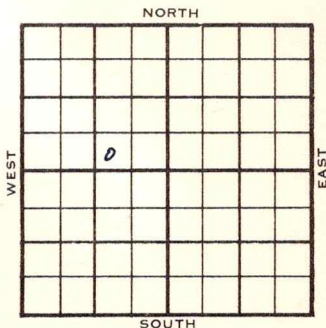

1955	ELEVATION 1411'	REPORT
------	--------------------	--------

11/9 Loc

1956

1-5  
 Comm. 11-15-55  
 8 5/8" @ 268/225  
 5 1/2" @ 4699/100  
 CO  
 PB 4665, 96/ 4606-40, 192/ 4550-98  
 frac,  
 Comp. 90 bopd, 60 BW  
**Log tops:**  
 H. 3644  
 L. 3836  
 M. 4538-4536  
 TD 4700'

~~ABANDONED~~

COMPLETED

County Barber Elev. \_\_\_\_\_  
 Sec. 32 Twp. 33 Rge. 11W  
 Company Continental  
 FarmName U. B. Harbaugh No. 15

TOPS	DEPTH	LOG	DATUM
Anh.			
Tp.			
H.			
Tr.			
Dg.			
B.L.			
L.			
K.C.			
B.K.C.			
Ce.			
C.			
M.			
M.			
K.			
Mz.			
Ma.			
V.			
S.			
S.			
A.			
R.			
Pe.			
G.			
T.D.			

Loc. in Sec. SW SE NW  
 Geol. \_\_\_\_\_  
 Contr. Noble  
 Pool Rhoades

NOV 9 '55  
 0  
 FIRST REPORT

Date Comm. \_\_\_\_\_  
 Location \_\_\_\_\_

\_\_\_\_\_  
 \_\_\_\_\_  
 \_\_\_\_\_  
 \_\_\_\_\_  
 \_\_\_\_\_  
 \_\_\_\_\_  
 \_\_\_\_\_

*26*

Co.  
 Lse.  
 No.  
 Sec.  
 T.  
 R.

County Barber Elev. 1411  
 Sec. 32 Twp. 33 Rge. 11W  
 Company Continental  
 Farm Name U. B. Harbaugh No. 15

TOPS	DEPTH	LOG	DATUM	Loc. in Sec.																														
Anh.				SW SE NW																														
Tr.																																		
H.		<u>3644</u>	<u>2233</u>																															
Dg.																																		
Bl.																																		
L.		<u>3836</u>	<u>2425</u>	Geol.																														
K.C.				Contr.																														
B.K.C.				<u>Noble</u>																														
Ce.				Pool																														
C.				<u>Rhodes</u>																														
M.	<u>4538</u>	<u>4536</u>	<u>3125</u>	<table border="1"> <tr><td></td><td></td><td></td></tr> <tr><td></td><td></td><td></td></tr> <tr><td></td><td></td><td></td></tr> <tr><td></td><td></td><td></td></tr> <tr><td></td><td></td><td></td></tr> <tr><td></td><td></td><td></td></tr> <tr><td></td><td></td><td></td></tr> <tr><td></td><td></td><td></td></tr> <tr><td></td><td></td><td></td></tr> <tr><td></td><td></td><td></td></tr> </table>																														
M.																																		
K.																																		
Mz.																																		
Me.																																		
V.																																		
S.																																		
S.																																		
A.																																		
R.																																		
Pe.																																		
G.																																		
T.D.	<u>4700</u>																																	

Date Comm. 11-15-55 JAN 5 1956  
8 5/8" @ 268/225 5 1/2" @ 4699/200 CO  
PB 4665 96/ 4606-40 192/ 4550-98  
frac Comp. 90 bopd 60 bw

Co.  
Lse.  
No.  
Sec.  
T.  
R.

COMPLETE