

Barber

KANSAS


SECTION 32 TOWNSHIP 33S RANGE 11W

WELL NO. #1 Hospital "B"

COMPANY Honaker-Davis C SW SE

NORTH ~~SE SE SE~~

15

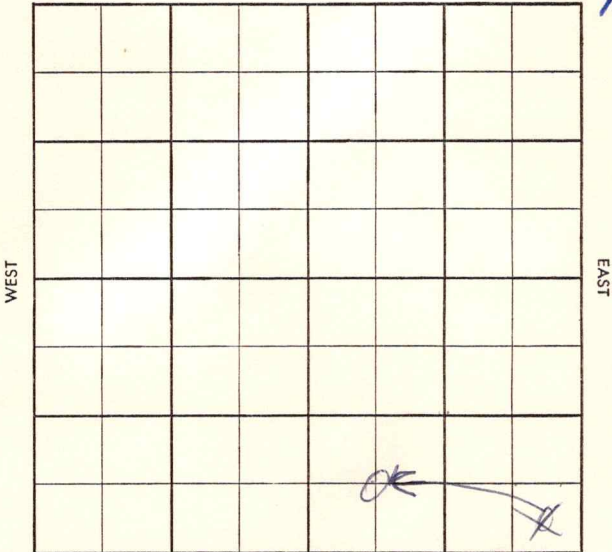

Twp. ~~X~~ Pool ~~X~~
Co. ~~246~~ Facet ~~246~~

S-513-B

County Barber Elev. _____
Sec. 32 Twp. 33 Rge. 11W
Company Honaker-Davis
Farm Name Hospital "B" No. 1

TOPS	DEPTH	LOG	DATUM
Anh.			
Tp.			
H.			
Tr.			
Dg.			
B.L.			
L.			
K.C.			
B.K.C.			
Ce.			
C.			
M.			
M.			
K.			
Mz.			
Mq.			
V.			
S.			
S.			
A.			
R.			
Pf.			
G.			
T.D.			

Loc. in Sec. SE SE SE

Geol. _____
Contr. _____
Co. Tools # 4

Pool _____
R. odes h



Date Comm. _____
M I R T

Co.

Lse.

No.

Sec.

T.

R.

CORRECTION

Twp. Pool

Co. Facet

S-513-B

County Barber Elev. 13920 F 13958 B
 Sec. 32 Twp. 33 Rge. 11W
 Company Honaker-Davis
 Farm Name Hospital "B" No. 1

TOPS	DEPTH	LOG	DATUM	Loc. in Sec.
Anh.				<u>SE SE SE</u>
Tp.				<u>CSW SE</u>
H.				
Tr.				
Dg.				
B.L.				
XL.	<u>3838</u>			Bill Iverson
K.C.				Geol.
B.K.C.				Contr.
Ce.				Co. Tools #4
C.	<u>4523</u>			
M.				Pool
K.	<u>4708</u>			Rodes
Mz.				
Mq.				
V.				
S.				
S.				
A.				
R.				
Pf.				
G.				
T.D.	<u>4726</u>			

Date Comm. 8-5-58 85206
 M I R T AUG 13 '58 03237 AUG 20 '58 Top
DST 4524-70 1hr 30'm FP 25-35
BHP 55-55 Top

D & A