

Section 36 Township 33 Range 11W

Well No. #1 Powell

Company Rupp-Ferguson

NORTH

13

WEST

EAST

0							

SOUTH

Barber KANSAS

SEC.	TWP.	R.
36	33	11W

WELL NO.	1 Powell	FARM
COMPANY		

Rupp-Ferguson


CONTRACTOR	Co. tools
	Wildcat

_____ Ft. from N. Line

330 _____ Ft. from S. Line

_____ Ft. from E. Line

330 _____ Ft. from W. Line

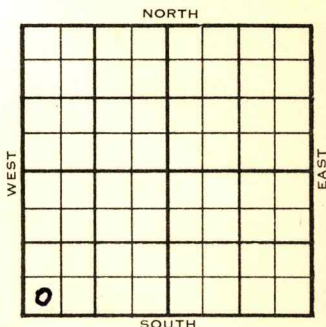

SW SW SW Sunray- DHM Superior-FO

	ELEVATION	REPORT
1954	1441'	

8/11 Spdg 8-10-54
8" @ 227
WOC

8/25 Spud 8-10-54 D & A TD 4685
8" @ 227 Anhy 840 Lgin sd 3501
Doug. 3695 Lans 4157 Miss 4585
DST 4585-97 open 2 hr rec 10' GCM
540' gas in pipe 812# TD 4685
D & A

ABANDONED

County **Barber** State **Kansas**
 Sec. **36** (Blk. **33** (Sur. **11W** Map No.

Operator **Rupp-Ferguson**

Well No. **1** Farm **Powell**

Elev. Location **SW SW SW**

FIRST REPORT

330 Ft. From **S** Line **SW**

330 Ft. From **W** Line Quarter

1st. Report **AUG 11 1954**

Completion

Remarks **Sunray - DEM**
Superior - FO

Co. tools

Spudding Date **8-10-54**

Drlg. Data

Wildcat

8" @ 227 WOC

County Barber State KansasSec. 36 (Blk. Twp.) 33 (Sur. Rge.) 11W Map No.Operator Rupp-FergusonWell No. 1 Farm PowellElev. 1441 Location SW SW SW330 Ft. From S Line SW330 Ft. From W Line Quarter

1st. Report

Completion AUG 25 1954Remarks WildcatCo. toolsSpudding Date 8-10-54Drlg. Data D & A TD 46858" @ 227 Anhy 840 Elgin sd. 3501Doug. 3695 Lans. 4157 Miss. 4585DST 4585-97 open 2 hr. Rec. 10' gcm540' gas in pipe 812# TD 4685D & A

FABEN GILSTRAP