


Section 14 Township 33 Range 11 W

Well No. #2 Circle

Company Sinclair O & G

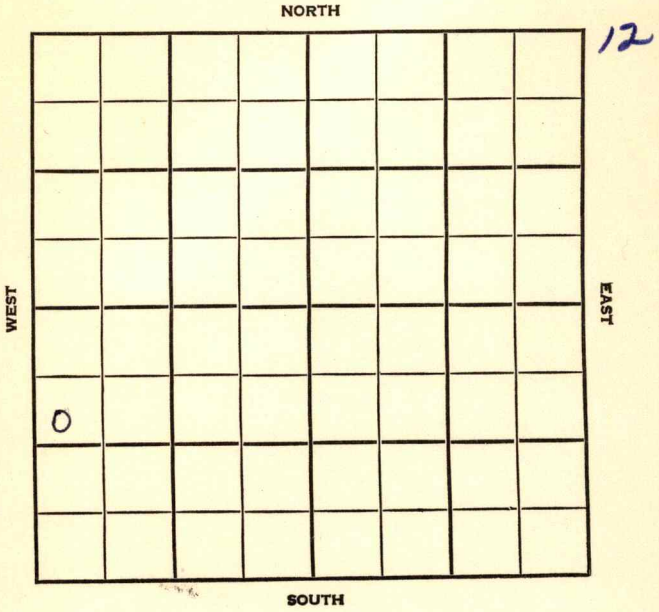

Barber

KANSAS

SEC. 14	TWP. 33	R. 11W
---------	---------	--------

WELL NO.

#2 Circle

FARM

COMPANY

Sinclair O&G

CONTRACTOR

Ben Brack

Rhoades


_____ Ft. from N. Line

_____ Ft. from S. Line

_____ Ft. from E. Line

_____ Ft. from W. Line

SW NW SW

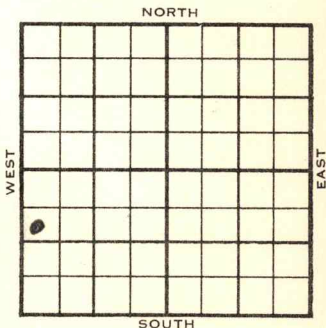

1955	ELEVATION 1419'	REPORT
------	--------------------	--------

8/3 Comm 7-29-55 **FIRST REPORT**
 10" @240/200 Drlg. 1575

9-7 DST 4522-57, open 3 hr., gas in 75 min.
 rec. 150' vsg&ocm, 60' free oil
 560/30"

5 1/2" @ 4630/250, 48/ 4552-58 500 A
 S/ .22 boph
 frac F/ 5 boph
 COMP. F/ 174 bopd 1% wtr.

<u>Tops</u>	<u>Depth</u>	<u>Log</u>
H.	3562	3561
Tr.		3584
Dg.	3694	3599
B.L.		3648
L.	3770-	3768
M.	4445	4446

T.D. 4632' - 4631'

COMPLETED

County Barber Elev. 1419

Sec. 14 Twp. 33 Rge. 11W

Company Sinclair O & G

Farm Name Circle No. 2

TOPS	DEPTH	LOG	DATUM
Anh.			
TP.			
H.			
Tr.			
Dg.			
BL.			
L.			
K.C.			
B.K.C.			
Ce.			
C.			
M.			
M.			
K.			
Mz.			
Me.			
V.			
S.			
S.			
A.			
R.			
PC.			
G.			
TD.			

Loc. in Sec. SW NW SW

Geol. _____
 Contr. Ben Brack

Pool Rhoades

FIRST REPORT		
6		
AUG 3 '55		

Date Comm. 7-29-55
10" @ 240/200 drlg. 1575

26

Co. No. Sec. T. R.

County Barber Elev. 1419
 Sec. 11 Twp. 33 Rge. 11W
 Company Sinclair O & G
 Farm Name Circle No. 2

TOPS	DEPTH	LOG	DATUM
Anh.			
Tr.			
H.	<u>3562</u>	<u>3561</u>	<u>2142</u>
Tr.		<u>3584</u>	<u>2165</u>
Dg.	<u>3694</u>	<u>3599</u>	<u>2180</u>
B.L.		<u>3648</u>	<u>2229</u>
L.	<u>3770</u>	<u>3768</u>	<u>2349</u>
K.C.			
B.K.C.			
Ce.			
C.			
M.	<u>4445</u>	<u>4446</u>	<u>3027</u>
M.			
K.			
Mz.			
Mq.			
V.			
S.			
S.			
A.			
R.			
Pe.			
G.			
T.D.	<u>4632</u>	<u>4631</u>	

Loc. in Sec. SW NW SW
 Geol. _____
 Contr. _____
Ben Brack
 Pool _____
Rhoades

COMPLETE		
0		

Date Comm. 7-29-55 SEP 7 1955
10" @ 240/200 DST 4522-57 open 3 hr.
gas in 75 min. Rec. 150' vsg & ocm
60' free oil 560/30" 5 1/2" @ 4630/250
148/ 4552-58 500 A S/ .22 boph
frac F/ 5 boph Comp. F/ 174 bopd 1% wtr

Co. Lse. No. Sec. T. R.