

KANSAS Barber

Section 15 Township 33 Range 11W

Well No. 1 Page Est.

Company Barbara Oil & Gas

Wildcat

NORTH

13

WEST

EAST

0							

SOUTH

Barber **KANSAS**

Sec. 15 Twp. 33 R. 11W

Well No. #1 Page Est. Farm

Barbara Oil & Gas Company

Wildcat (Patton Drlg. Cont.) **NORTH**


 Ft. from N. Line

330' Ft. from S. Line

 Ft. from E. Line

330' Ft. from W. Line

SW/C

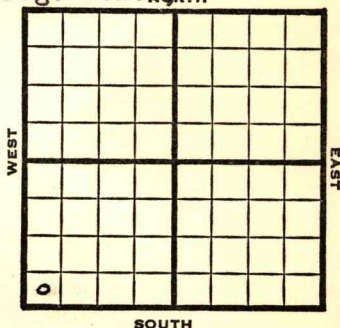

1949

Elev 1435' REPORT

7/13 Surface Hole

7/20 100@ 336'

Drlg 2060'

7/27 Drlg 3768'

8/3 Miss 4475'

Drlg. 4565'

8/10 TD 4610'

7"@ 4609'

8/17 32 shots 4546-4565

Flow & swb 97 bbls oil 7 hrs

Gravity 24.5°

8/24 "

8/31 "

9/7 "

9/14 "

9/21 "

9/28 "

10/5 "

10/12 TD 4610'

Miss 4475'

7"@ 4609'

Perf

Pump 146 Oil Pot

245 Gr.

Comp

COMPLETED

Kansas

Map No. _____ Sec. 15 Twp. 33 R. 11WWell No. 1 Page Est. _____

Barbara Oil & Gas _____ Company

Patton Drlg. _____ Contractor

SW/C

FIRST REPORT
SECTION FLAT

_____ Ft. from N. Line

330 Ft. from S. Line

_____ Ft. from E. Line

330 Ft. from W. Line

Barber County

Location _____

Rig up _____

Drilling and Remarks:

surface hole

RECORD

Cased _____ in., _____ ft.

Sand _____

Gas _____

Oil _____

Total Depth _____

PRODUCTION

1st 24 hrs. Nat. _____

1st 24 hrs. after shot _____

Gas _____ Cu. Ft.

Dry Hole _____

Abandoned _____

Date

JUL 13 1949 19S. J. LEWIS Scout

Kansas


Map No. _____ Sec. 15 Twp. 33 R. 11WWell No. 1 Page E Est. _____

Barbara Oil & Gas Company

COMPLETE

Contractor

SW/C

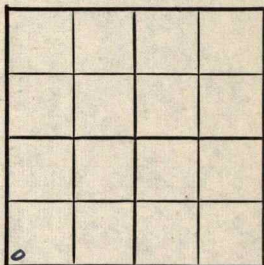E. 1, 1435.
SECTION PLAT

_____ Ft. from N. Line

330 Ft. from S. Line

_____ Ft. from E. Line

330 Ft. from W. Line

Barber County

Location _____

Rig up _____

Drilling and Remarks:

*Wise 4475.**7" @ 4609**Prof.**Pump 146 oil Pat**245/82*

RECORD

Cased _____ in., _____ ft.

Sand _____

Gas _____

Oil _____

Total Depth 4610

PRODUCTION

1st 24 hrs. Nat. _____

1st 24 hrs. after shot _____

Gas _____ Cu. Ft.

Dry Hole _____

Abandoned _____

Date

OCT 12 1949

19

S. J. LEWIS

Scout