

Section 15 Township 33 Range 11 W

Well No. #5 Page Est. "A"

Company Barbara Oil

NORTH

5

WEST

0							

EAST

SOUTH

Barber

KANSAS

Sec. 15 Twp. 33 R. 11W ✓

Well No. #5 Page Est. "A" Farm

Barbara Oil Company

Patton Drlg. - Contr. Contractor

Roads Pool


\_\_\_\_\_ Ft. from N. Line

330' Ft. from S. Line

\_\_\_\_\_ Ft. from E. Line

330' Ft. from W. Line

SW SW NW

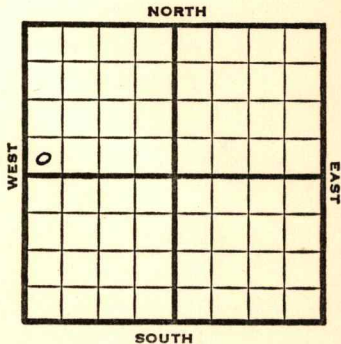

1951

Elev. 1449'

REPORT

1/24  
3/28

Cellar & Pits  
 Spud 1-28-51  
 Oil Well TD 4564  
 13" @ 211  
 Doug 3696' KC 3774  
 Miss 4473'  
 7" @ 4535 TD 4544'  
 FU 300' oil  
 90 qt/on botton @ 4564  
 S/200 bopd Comp. 252 bopd

COMPLETE

County Barber State Kansas

Sec. 15 (Blk.) 33 (Sur.) 11W Map No.

Operator Barbara Oil

Well No. 5 Farm Page Est. "A"

Elev. 1449 Location SW SW NW


330 Ft. From S Line NW

330 Ft. From W Line Quarter

Ist. Report

Completion MAR 28 1951

Remarks Roads Pool

Patton Drlg. - Contr.

Spudding Date 1-28-51

COMPLETE

Drlg. Data Oil well TD 4564

13" @ 211 Doug. 3696 KC. 3774

Miss. 4473 7" @ 4535 TD 4544 FU 300'

oil 90 qt/ on bottom @ 4564

S/ 200 bopd Comp. 252 bopd

J. E. TYRA

