


Section 15 Township 33 Range 11W

Well No. #11 Page Est (A)

Company Barbara Oil

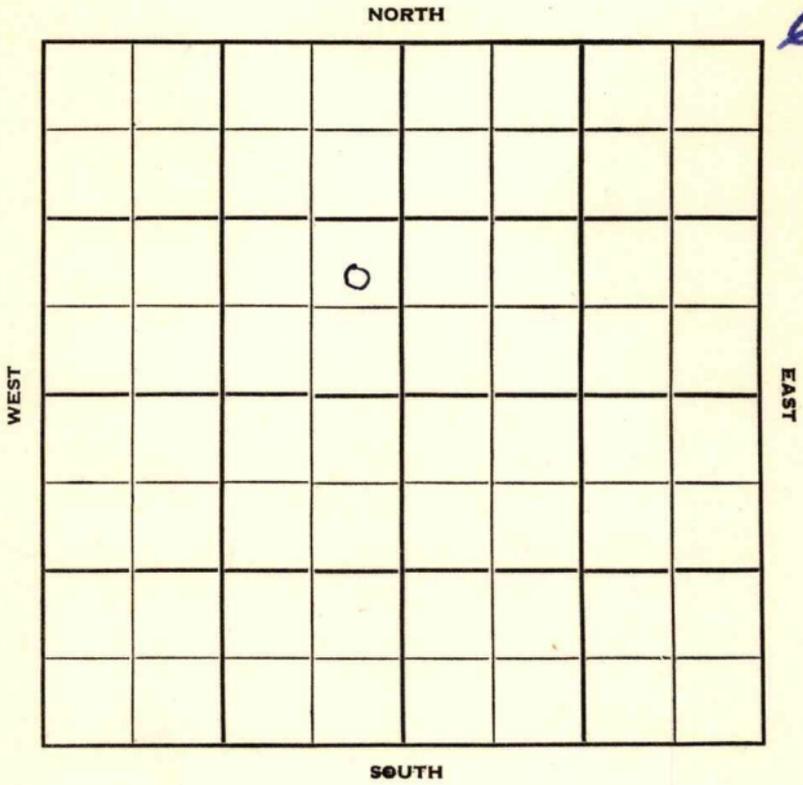

Sec. 15 Twp. 33 R. 11W

Well No. #11 Page Est (A) Farm

Barbara Oil Company


Patton -Contr. Contractor

Ft. from N. Line

990' Ft. from S. Line

330' Ft. from E. Line

Ft. from W. Line

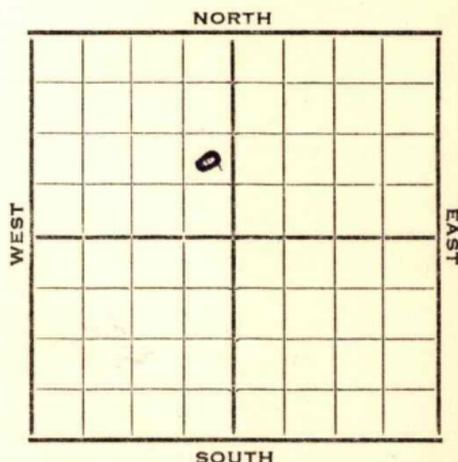

NE SE NW

1952 Elev. 1472 REPORT

6/18 Location  
6/25 RUR  
7/2 8" @ 196  
Drlg. 2155'  
7/9 Douglas 3704  
Drlg. 3845'  
7/17 Miss 4490'  
Cored 4500'-21 , 21'  
Drlg ahead  
7/23 F 3521-42  
DST 4495-4542, 1 hr. 30' m  
F 4542-92, pay 4555-90  
RTD 4592 7" @ 4542'  
7/30 CO 4592' gas at once  
F 150 Bopd by heads  
8/6 NR  
8/13 "  
8/20 Spud 6-26-52 Oil Well TD 4592  
8" @ 196 Doug 3704 Miss 4490  
DST 4495-4542 opn 1hr. Rec. 30' mud  
7" @ 4542 TD 4592 F/150 bopd  
S/44 boph Comp. 347 bopd

COMPLETED

County **Barber** State **Kansas**

Sec. **15** (Blk.) **33** (Sur.) **11W** Map No.

Operator **Barbara Oil**

Well No. **11** Farm **Page Est (A)**

Elev. Location **NE SE NW**

		0			

**FIELD REPORT**

**990** Ft. From **S** Line **NW**

**330** Ft. From **E** Line **Quarter**

1st. Report **JUN 1 8 1952**

Completion

Remarks

**Patton - Contr.**

Spudding Date

Drlg. Data

**Location**

**J. G. McGEHEE**

