


Section 15 Township 33 Range 11W

Well No. 12 - Page "A"

Company Barbara Oil

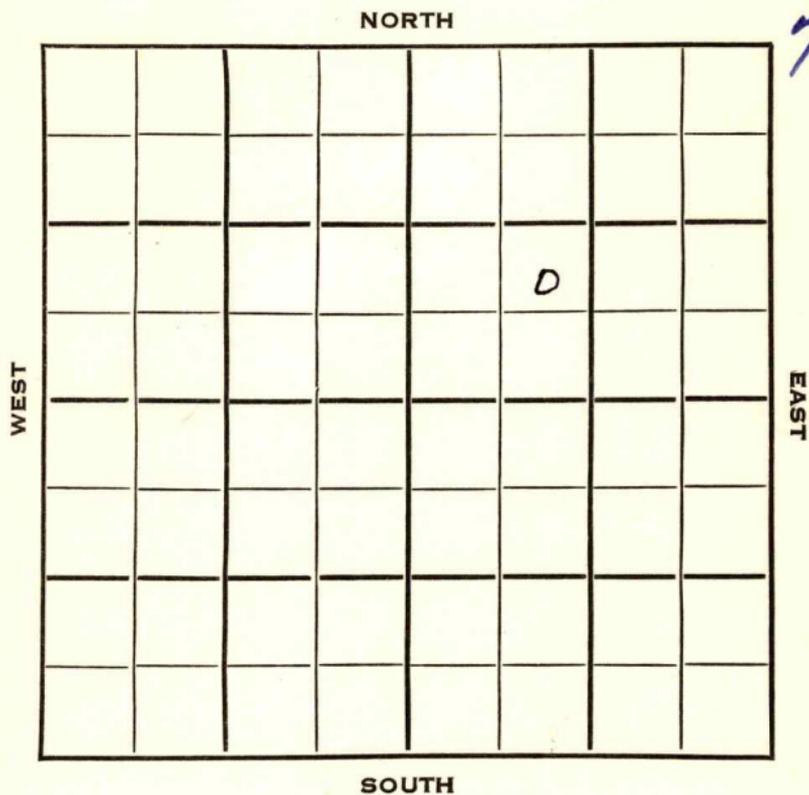

Sec. 15 Twp. 33 R. 11W

Well No. #12 Page "A" Farm _____

Barbara Oil Company _____

Patton Drlg. Contractor _____

Rhodes Pool


_____ Ft. from N. Line

990 Ft. from S. Line

_____ Ft. from E. Line

990 Ft. from W. Line

NE SW NE

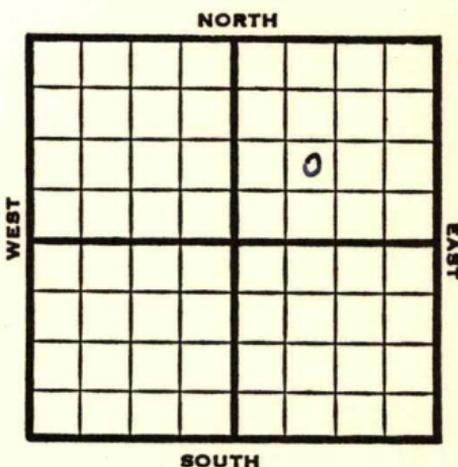

1953

Elev. 1475' REPORT

1/14

RUR

1/22

12" @ 179

1/29

Drlg. 2623'

2/5

Drlg. 4165'

2/12

Doug 3730, Lans 3798, Miss 4491

DST 4496-4543, 3/4 hrs., est

100,000 gas, 92' GCM, 1405#

TD 4592

7" @ 4550

2/19

NR

2/26

CO 4592 1 BOPH 24 hrs. 3000A

3/12

Testing

3/18

Spud 1-18-53 Oil well TD 4592'

12" @ 179 **Doug. 3730 Lans 3798**

Miss 4491

DST 4496-4543 open 3/4 hr. 100,000

gas, 92' GCM 1405# TD 4592'

7" @ 4550 CO to 4592 S/1 BOPH

24 hrs. 3000 A S/14 BOPH 4 hr.

F/4 BOPH 4 hr. P/9 BOPH 8 hr.

P/157 BOPD

Comp. 206 BOPD

COMPLETED

County Barber State ~~Kansas~~

Sec. 15 (Blk. Twp.) 33 (Sur. Rge.) 11W Map No.

Operator Barbara Oil

Well No. 12 Farm Page "A"

Elev. 1475 Location NE SW NE

			o	
COMPLETE				

990 Ft. From S Line NE

990 Ft. From W Line Quarter

1st. Report

Completion MAR 18 1953

Remarks Rhodes Pool

Patten Drlg. - Contr.

Spudding Date 1-18-53

Drlg. Data Oil well TD 4592

12" @ 179 Doug. 3730 Lans. 3798

Miss. 4491 DST 4496-4543 open 3/4 hr.

100,000 gas 92' gcm 1405# TD 4592

7" @ 4550 CO to 4592 S/ 1 boph 24 hr.

3000 A S/ 14 boph 4 hr. F/ 4 boph

4 hr. P/ 9 boph 8 hr. P/ 157 bopd

Comp. 206 bopd

