


Section 16 Township 33 Range ~~12W~~

11W

Well No. #6 Newkirk

Company Sinclair Oil & Gas Co.

12

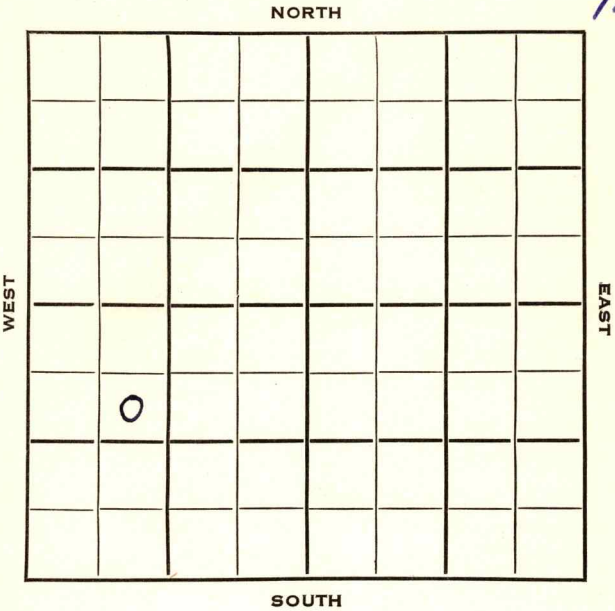

Barber

KANSAS ✓

Sec. 16 Twp. 33 R. ~~12W~~ 11W

Well No. #6 Newkirk Farm

Sinclair Oil & Gas Co. Company

Contractor

Rhodes


990 Ft. from N. Line

Ft. from S. Line

Ft. from E. Line

990 Ft. from W. Line

SE NW SW

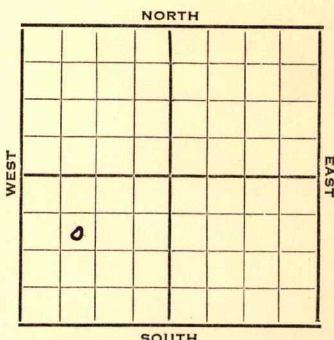

1953

Elev. 1456'

R E P O R T

7/8

Location

7/22

10" @ 712'

Heeb 3594, Tor 3620, Doug 3640, Lans 3800

Drlg 4490'

8/19

Spud 7-10-53

Oil Well

TD 4575

10" @ 217

Heeb 3594, Tor 3620, Doug 3640, Lans 3800, Miss 4472

TD 4538

7" @ 4528

DST 4482-4519, opn 1 hr., rec. 145' gas, 35' mud, 155#

DST 4519-38, opn 1 hr., est 25,000 gas 95' o & gcm, 90' oily mud, 90% oil 1012#

CO to 4534, DD 4569

FU 1300' oil, S/25 bo 6 hrs.


DD 4575,

Miss 4573

Hydro. S/7½ boph 10 hrs.

Comp. 47 bopd 13 bw

COMPLETED

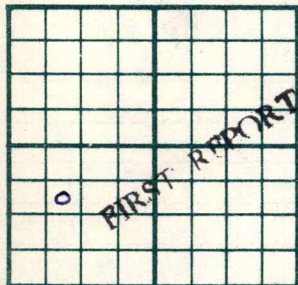County **Barber** State **Kansas**Sec. **16** (Blk.) **33** (Sur.) **12W** Map No.Operator **Sinclair Oil & Gas Co.**Well No. **6** Farm **Newkirk**Elev. Location **SE NW SW**990 Ft. From **N** Line **SW**990 Ft. From **W** Line Quarter1st. Report **JUL 8 1953**

Completion

Remarks

Spudding Date

Drlg. Data **Rhodes**

Location

J. G. McGEHEE

Kansas

Map No. _____ Sec. 16 Twp. 33 R. 11WWell No. 6 NewkirkSinclair

Company

CORRECTION

Contractor

SE NW SW

SECTION PLAT

990 Ft. from N. Line

_____ Ft. from S. Line

_____ Ft. from E. Line

990 Ft. from W. Line

o			

Barber County

Location _____

Rig up _____

Drilling and Remarks:

Reported

16-33-12W

RECORD

Cased _____ in., _____ ft.

Sand _____

Gas _____

Oil _____

Total Depth _____

PRODUCTION

1st 24 hrs. Nat. _____

1st 24 hrs. after shot _____

Gas _____ Cu. Ft.

Dry Hole _____

Abandoned _____

Date

AUG 12 1953J. G. McGEHEE

Scout

County Barber State Kansas
 Sec. 16 (Blk.) 33 (Sur.) 11W Map No.
 (Twp.) (Rge.)
 Operator Sinclair Oil & Gas
 Well No. 6 Farm Newkirk
 Elev. 1456 Location SE NW SW



990 Ft. From N Line SW
990 Ft. From W Line Quarter
 1st. Report
 Completion AUG 19 1953
 Remarks Rhodes Pool

Spudding Date 7-10-53

Drig. Data Oil well TD 4575
10" @ 217 Heeb. 3594 Tor. 3620
Doug. 3640 Lans. 3800 Miss. 4472
TD 4538 7" @ 4528 DST 4482-4519
open 1 hr. Rec. 145' gas 35' mud 155#
DST 4519-38 open 1 hr. est. 25,000 gas
95' o & gcm 90' oily mud 90% oil
1012# CO to 4534 DD 4569 FU 1300' oil
S/ 25 bo 6 hr. DD 4575 Miss. 4573
Hydro. S/ 7½ boph 10 hr.
Comp. 47 bopd 13 bw

J. G. McGEHEE