

Section 16 Township 33 Range 11 W

Well No. # 8 Newkirk

Company Sinclair

NORTH

13

WEST

EAST

o							
	X						

SOUTH

Barber

KANSAS

SEC.	TWP.	R.
16	33	11 W

WELL NO. # 8 Newkirk FARM

COMPANY Sinclair

CONTRACTOR G-M-R

Rhodes Pool


_____ Ft. from N. Line

330 990 Ft. from S. Line

_____ Ft. from E. Line

990 330 Ft. from W. Line

~~SE~~ NW SW SW

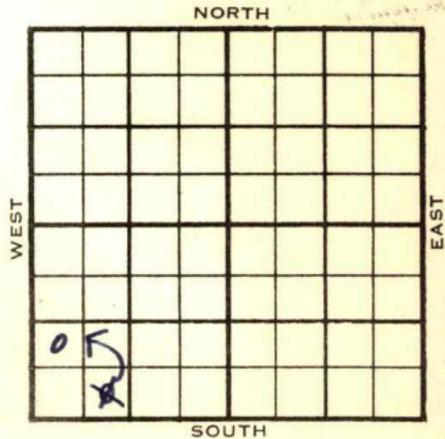

1954	ELEVATION	REPORT
	1450'	

12/15
1955
2/2

Location

Spud 12-16-54 Oil well TD 4665
 10" @ 247 Heeb 3577 Tor. 3616
 Doug 3630 Lans 3805 Miss 4480
 TD 4665' 5" @ 4663
 Schl tops: Doug 3634, Doug. sd. 3716,
 Lans. 3802, Miss. 4478,
 CO to 4625 168/4521-63 FU 1000' oil
 3 1/2 hr. 500 A sd-oil-frac. F/369 BO
 3/4 BW 22 hr. Comp. F/162 BOPD 5/10
 of 1% wtr.

COMPLETED

Kansas

Map No. _____ Sec. 16 Twp. 33 R. 11W

Well No. 8 Newkirk

Sinclair Company

CORRECTION

Contractor

NW SW SW

SECTION PLAT

o			

_____ Ft. from N. Line

990 Ft. from S. Line

_____ Ft. from E. Line

330 Ft. from W. Line

Barber County

Location _____

Rig up _____

Drilling and Remarks:

Reported

SE SW SW

RECORD

Cased _____ in., _____ ft.

Sand _____

Gas _____

Oil _____

Total Depth _____

PRODUCTION

1st 24 hrs. Nat. _____

1st 24 hrs. after shot _____

Gas _____ Cu. Ft.

Dry Hole _____

Abandoned _____

Date

FABEN GILSTRAP

DEC 22 1954 19

Scout

