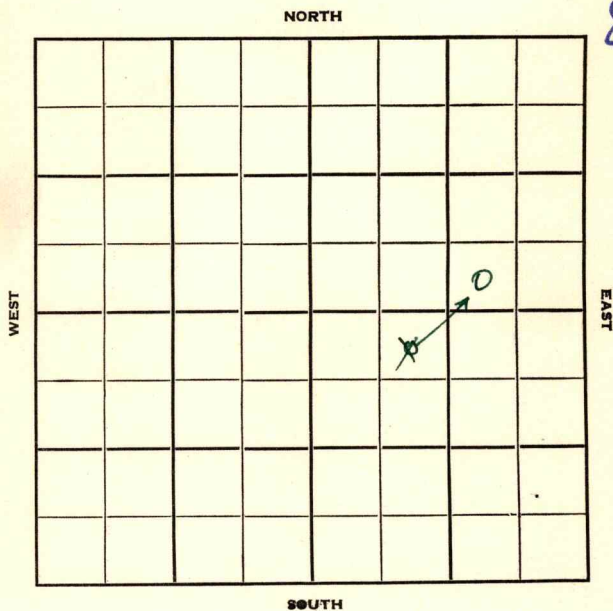


Section 16 Township 33 Range 11WWell No. #7 Page Est. "C"Company Barbara Oil

Barber **KANSAS**

Sec. 16 Twp. 33 R. 11 W

Well No. # 7 Page Est. "C" Farm

Barbara Oil Company

Contractor

Rhoades Pool


~~330~~ Ft. from N. Line

330 Ft. from S. Line

990 Ft. from E. Line

~~990~~ Ft. from W. Line

~~SW SENE~~
~~NE NW SE~~

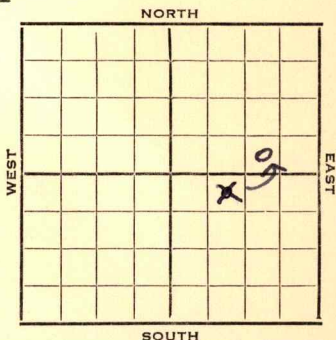

1951 **Elev. 1417'** REPORT

11/21 Location

1952

1/29

Spud 12-1-51

Oil well TD 4540

8" @ 196 **Doug. 3668** **Lans. 3686**

Miss. 4464 5" @ 4496 TD 4529

S/ 2 BOPH 12 hr. DD 4540

100 qt./ 4500-40 P/ 8 BOPH 8 hr.

Comp. 193 BOPD

COMPLETED

Kansas

Map No. _____ Sec. 16 Twp. 33 R. 11WWell No. 7 Page Est. "C"Barbara Oil


Company

CORRECTION

Contractor

SW SE NE

SECTION PLAT

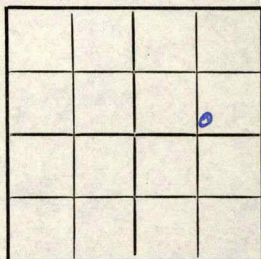

_____ Ft. from N. Line

330 Ft. from S. Line990 Ft. from E. Line

_____ Ft. from W. Line

Barber County

RECORD

Location _____

Cased _____ in., _____ ft.

Rig up _____

Sand _____

Drilling and Remarks:

Gas _____

Oil _____

Total Depth _____

Reported

NE NW SE

PRODUCTION

1st 24 hrs. Nat. _____

1st 24 hrs. after shot _____

Gas _____ Cu. Ft.

Dry Hole _____

Abandoned _____

Date

DEC 12 1951

19

J. E. TYRA

Scout

