


Section 17 Township 33 Range 11W

Well No. 1 Newkirk

Company Gulf Oil

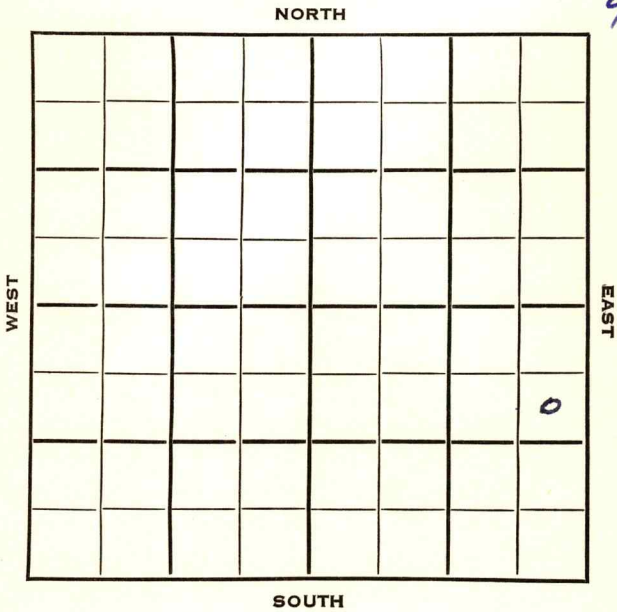

Barber

KANSAS

SEC.	TWP.	R.
17	33	11 W

WELL NO.

1 Newkirk

FARM

COMPANY

Gulf Oil

CONTRACTOR

Barbour Drlg.

Wildcat


3626 Ft. from N. Line

Ft. from S. Line

330 Ft. from E. Line

Ft. from W. Line

SE NE SE

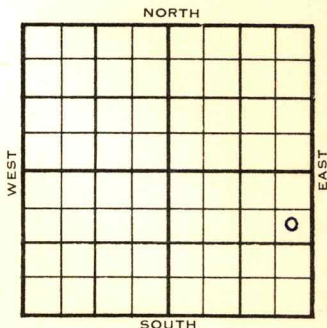

1954

ELEVATION

1424'

REPORT

5/5

MIR

5/12

10" @ 207'

Drlg 2925'

5/19

Heeb 3585', Doug sho 3660'

DST 3641'-50' 1 hr, 3' M Doug Sd 3689'

DST 3690'-98' 1 hr, 1460' SW

1460#

Lans 3787'

Drlg 4200'

5/26

Miss 4445'

DST 4450-75', 3/4 hrs., 40,000' gas,

45' SGCM, 1321#

DST 4475-4505', 1 hr., 60,000 gas, 205'

O&GCM, 1405#

DST 4505-35', 3/4 hrs., 215' hly O&GCM,

V 4700'

DST 4782-4800', 1 hr., 12' M,

Simp 4853'

DST 4800-4855', 3/4 hrs., 55' M,

1096#

RTD 4855' Schl

6/2

7" @ 4630'

OVER

1954
7/21

Spud 5-4-54

Oil Well

TD 4855'

10" @ 207'

Heeb 3585', Doug 3660'

DST 3641-50', opn 1 hr., rec. 3' mud,
O#

Doug 3689'

DST 3690-98', opn 1 hr., rec. 1460' SW
1460#

Lans 3787', Miss 4445'

DST 4450-75', opn 3/4 hrs., rec.

40,000 gas, 45' sgcm, 1324#

DST 4475-4505', opn 1 hr., rec. 60,000
gas, 205' o & gcm, 1405#

DST 4505-35', opn 3/4 hrs., rec. 215'
ho & gcm,

Viola 4780'

DST 4782-4800', opn 1 hr., rec. 12'
mud,

Simp. 4853'

DST 4800-55', opn 3/4 hrs., rec. 55'
mud, 1096#

TD 4855'

7" @ 4630'

CO to 4588'

32/4490-98, 96/4508-32, B/30 go 51
gwph 5 hrs.

S/15 bo 20 hrs., frac.

F/134 bo 8 hrs.

F/25 boph

Comp. 277 bopd 21% wtr.

COMPLETED

County **Barber** State **Kansas**

Sec. **17** (Blk. Twp.) **33** (Sur. Rge.) **11W** Map No.

Operator **Gulf Oil**

Well No. 1 Farm Newkirk

Elev.	Location	SE NE SE
-------	----------	----------

FIRST REPORT

3626 Ft. From N Line Sec.

330 Ft. From E Line Quarter

1st. Report **MAY** 5 1954

Completion

Remarks

Barbour Drlg. - Contr.

Spudding Date _____

Drlg. Data Wildcat

M I R

County	Barber		State	Kansas	
Sec.	17	(Blk. Twp.)	33	(Sur. Rge.)	11W Map No.
Operator	Gulf Oil				
Well No.	1	Farm	Newkirk		
Elev.	1424	Location	SE NE SE		
			3626 Ft. From	N Line	Sec.
			330 Ft. From	E Line	Quarter
			1st. Report		
			Completion JUL 21 1954		
			Remarks Wildcat		
			Barbour - Contr.		
			Spudding Date 5-4-54		
Drlg. Data Oil well			TD 4855		

10" @ 207 Heeb. 3585 Doug. 3660

DST 3641-50 open 1 hr. Rec. 3' mud

O# Doug. 3689 DST 3690-98 open 1 hr.

Rec. 1460' sw 1460# Lans. 3787

Miss. 4445 DST 4450-75 open 3/4 hr.

Rec. 40,000 gas 45' sgcm 1324#

DST 4475-4505 open 1 hr. Rec. 60,000

gas 205' o & gcm 1405# DST 4505-35

open 3/4 hr. Rec. 215' ho & gcm

Viola 4780 DST 4782-4800 open 1 hr.

Rec. 12' mud Simp. 4853 DST 4800-55

open 3/4 hr. Rec. 55' mud 1096#

TD 4855 7" @ 4630 CO to 4588

32/ 4490-98 96/ 4508-32 B/ 30 go 15


J. G. McGEHEE

Drlg. Data

15 gwph 5 hr. S/ 15 bo 20 hr.

frac F/ 134 bo 8 hr. / F/ 25 boph

Comp. 277 bopd 21% wtr.

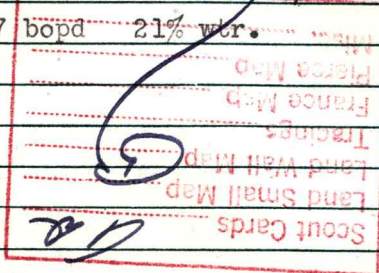

JUL 27 1954