

Section 16 Township 33 Range 11W

Well No. #8 Page est. (C)

Company Barbara Oil

NORTH

8

							0

WEST

EAST

SOUTH

Barber

KANSAS  
11W

Sec. 16 Twp. 33 R. 11W

Well No. #8 Page Est (C) Farm

Barbara Oil Company

Contractor

Rhodes


Ft. from N. Line

990' Ft. from S. Line

330' Ft. from E. Line

Ft. from W. Line

NE SE NE

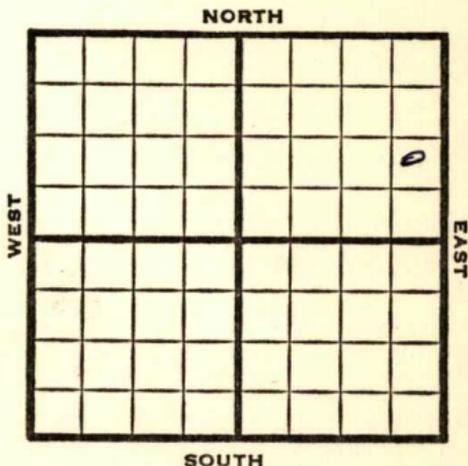

1952

**Elev. 1429'** REPORT

1/23 Cellar & Pits

2/6 Drlg. 2550'

2/13 **Anhy 1580**

Drlg. 4288'

2/20 **Doug 3670 KC 3742 Miss L 4440**

TD 4490 5" @ 4474

DD 4492 Fill up 3500 oil & est

3/4 M gas DD 4512 TD

F 25 BO in 3 hrs to run tub.

3/5 NR

3/12 F 299 BOPD

3/19 Spud 1-28-52

Oil well TD 4512' 8" @ 202

**Anhy 1580' Doug 3670' KC 3742'**

**Miss 4440' 5" @ 4474 TD 4492'**

FU 3500' oil 3/4 M gas DD 4512'

F/25 BO 3 hr. F/30 BOPH

Comp. 209 BOPD

**COMPLETED**

County **Barber** State **Kansas**

Sec. **16** (Blk.) **33** (Sur.) **11W** Map No.

Operator **Barbara Oil**

Well No. **8** Farm **Page est (C)**

Elev. Location **NE SE NE**


FIRST REPORT

**990** Ft. From **S** Line **NE**

**330** Ft. From **E** Line Quarter

Ist. Report **JAN 23 1952**

Completion

Remarks **JAN 23 1952**

Spudding Date

Drlg. Data **Rhodes**

**Cellar & Pits**

RECEIVED  
 DEPT. OF REVENUE  
 JAN 23 1952  
 J. E. TYRA

