


Section 16 Township 33 Range 11W
Well No. #10 Page "C"
Company Barbara Oil

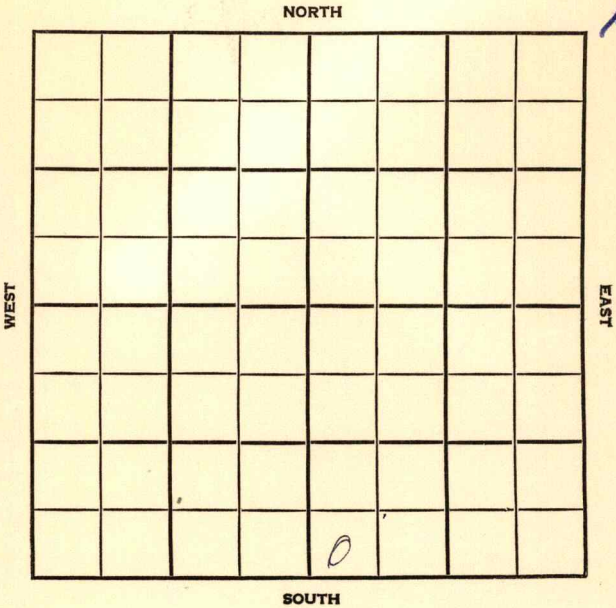

County Barber Elev. _____
 Sec. 16 Twp. 33 Rge. 11W
 Company Barbara Oil
 Farm Name Page "C" No. 10

TOPS	DEPTH	LOG	DATUM	Loc. in Sec.
Anh.				SW SW SE
Tp.				
H.				
Tr.				
Dg.				
Bl.				
L.				Geol.
K.C.				Contr.
B.K.C.				
Ce.				
C.				
M.				Pool
M.				Rhoades
K.				
Mz.				
Me.				
V.				
S.				
S.				
A.				
R.				
Pe.				
G.				
T.D.				

FIRST REPORT	
OCT 31 '56	

Date Comm. Cellar & pits

NOV 5 1956

R.C.

County BarberElev. 1431Sec. 16Twp. 33Rge. 11WCompany Barbara OilFarm Name Page "C"No. 10

TOPS	DEPTH	LOG	DATUM	Loc. in Sec.
Anh.				SW SW SE
Tp.				
H.				
Tr.				
Dg. <u>sd</u>	<u>3728</u>			
Bl.				
L.	<u>3786</u>			
K.C.				Geol.
B.K.C.				Contr.
Ce.				
C.				
M.	<u>4478</u>			
M.				Pool
K.				<u>Rhoades</u>
Mz.				
Mo.				
V.				
S.				
S.				
A.				
R.				
Pe.				
G.				
T.D.	<u>4610</u>			

Date Comm.

Cellar & pits NOV 7 '56 11-2-56 8 5/8

215/165 ID 3340 NOV 13 '56

ID 4296 NOV 21 '56 5 1/2 @ 4610 / 250

RUCT NOV 28 '56 92/4533-56 FU

100' oil 1hr 1400' oil 36 hrs

1/2 Frac DEC 5 '56 Flwd 500 BOPD

24 hrs no/w 18/64" ch. NOV 12 '56 DEC 10 '56

wo pot. DEC 26 '56 Ph Flw 262 BOPD

no/w 92/45 21.9° 20/64" ch