


DX 78-1

Section 17 Township 33 Range 11W

Well No. 4 Newkirk

Company Gulf Oil

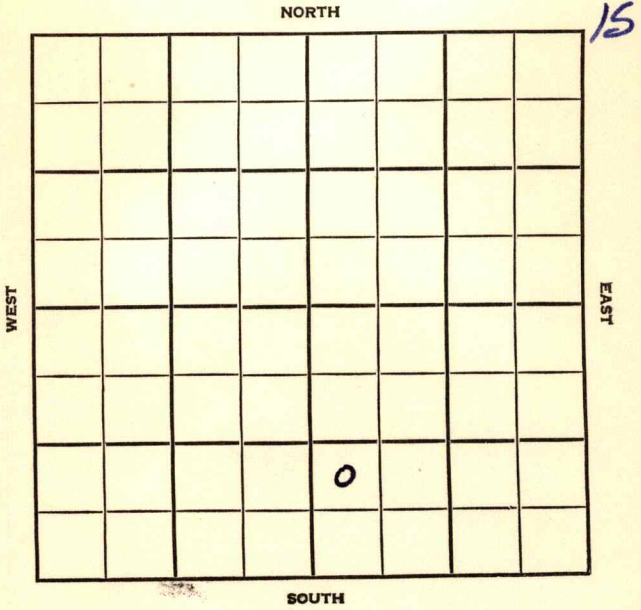

Barber

KANSAS

SEC.	TWP.	R.
17	33	11 W
WELL NO.		
# 4 Newkirk		
COMPANY		
Gulf Oil		
CONTRACTOR		

Barbour

Rhodes Pool


Ft. from N. Line

990 Ft. from S. Line

Ft. from E. Line

330 Ft. from W. Line

NW SW SE

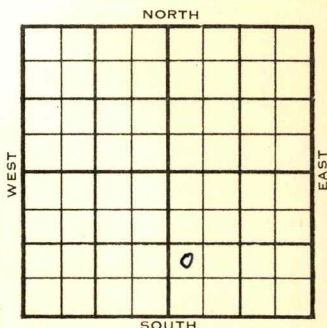

ELEVATION

REPORT

1954

1405'

8/4

MIR

9/29

Spud 8-7-54 Oil well TD 4595'
 8-5/8" @ 210 Heeb 3556 Tor. 3576
 Doug 3665 Lans 3740 B KC 4254
 Miss. 4424
 DST 4420-55 open 1 hr rec 28' drlg.
 mud, 660#
 DST 4455-81 open 1 hr gas in 18 min.
 38,000 CFGPD, rec 85' GCM 1035#
 DST 4481-4517 open 1 hr gas in 1/2 hr.
 15,400 CFGPD, rec 30' G & OCM, 90'
 frothy oil, 120' free oil, 1185#
 Le Comton Lime 4587' TD 4595'
 5" @ 4574
 Schl tops: Heeb 3556 Tor. 3576
 Doug 3665 Lans 3740 B KC 4254
 Miss lime 4424 LeCompton lime 4586
 PB 4540 CO to 4540 104/4474-4500
 B 1/2 BO 3/4 GWPH 12 hr.
 B 1/2 BO PH frac. F/211 BO 6 1/2 hrs.
 Comp. BHB 1214 BOPD

COMPLETED

FABEN GILSTRAP

Drlg. Data

B/ $\frac{1}{2}$ boph frac F/ 211 bo $6\frac{1}{2}$ hr.

Comp. BHB 1214 bopd

Scout Cards
Land Small Map
Land Wall Map
Tracings
France Map
Place Map
Misc.

[Handwritten signature]

OCT 13 1954

County **Barber** State **Kansas**

Sec. **17** (Blk. **33** (Sur. **11W** Map No.

Operator **Gulf Oil**

Well No. **4** Farm **Newkirk**[illegible]

FIRST REPORT

990 Ft. From S Line SE

330 Ft. From W Line Quarter

1st. Report AUG 4 1954

Completion

Remarks

Barbour - Contr.

Spudding Date _____

Drlg. Data Rhodes Pool

M I R