

Section 17 Township 33 Range 11 WWell No. # 8 NewkirkCompany Gulf Oil

NORTH

14

			0				

SOUTH

WEST

EAST

SEC.	TWP.	R.
17	33	11W

WELL NO.

8 Newkirk

FARM

COMPANY

Gulf Oil

CONTRACTOR


Rhodes Pool

_____ Ft. from N. Line

340 _____ Ft. from S. Line

330 _____ Ft. from E. Line

_____ Ft. from W. Line

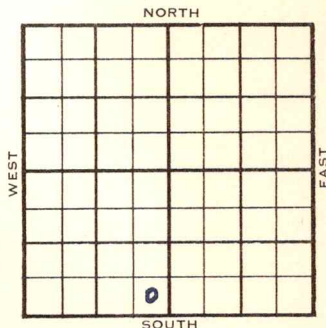


SE SE SW

	ELEVATION	REPORT
1954	1394'	
10/13	Spud 10-10-54 8" @235'	
11/23	Spud 10-10-54 Oil Well TD 4590' 8" @ 235' Doug 3659', Br. Lime 3733' Lans 3745' Heeb 3553' Miss 4411' DST 4416'-46' opn 1 hr, gas in 1 hr, rec 60' Mud 1005# LeCompton 4582' TD 4590' 5" @ 4587' DST 4446'-4506' opn 1 hr, rec 150' gc & socm 270' gas 330# CO to 4551' 40/ 4472-82 S/ 17 gsw 14 hr. frac. 200 A F/ 48 bo 14% Wtr. Comp F/ 299 bopd 8% Wtr.	

COMPLETED

FABEN GILSTRAP

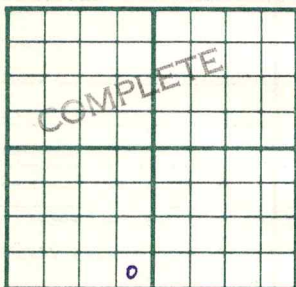County **Barber** State **Kansas**Sec. **17** (Blk. Twp.) **33** (Sur. Rge.) **11W** Map No.Operator **Gulf Oil**Well No. **8** Farm **Newkirk**Elev. **1394** Location **SE SE SW****340** Ft. From **S** Line **SW****330** Ft. From **E** Line **Quarter**

1st. Report

Completion **NOV " 3 1954**Remarks **Rhodes Pool**Spudding Date **10-10-54**Drlg. Data **Oil well** **TD 4590****8" @ 235** **Doug. 3659** **Br. lime 3733****lans. 3745** **Heeb. 3553** **Miss. 4411****DST 4416-46** **open 1 hr.** **gas in 1 hr.****Rec. 60' mud** **1005#** **LeCompton 4582****TD 4590** **5" @ 4587** **DST 4446-4506****open 1 hr.** **Rec. 150' go & soom** **270' gas****330#** **CO to 4551** **40/ 4472-82** **S/ 17 gsw****14 hr.** **frac** **200 A** **F/ 48 bo** **14% wtr.****Comp. F/ 299 bopd** **8% wtr.****FABEN GILSTRAP**