


DX 78-1

Section 17 Township 33 Range 11W

Well No. 3 W. A. Newkirk

Company Gulf Oil

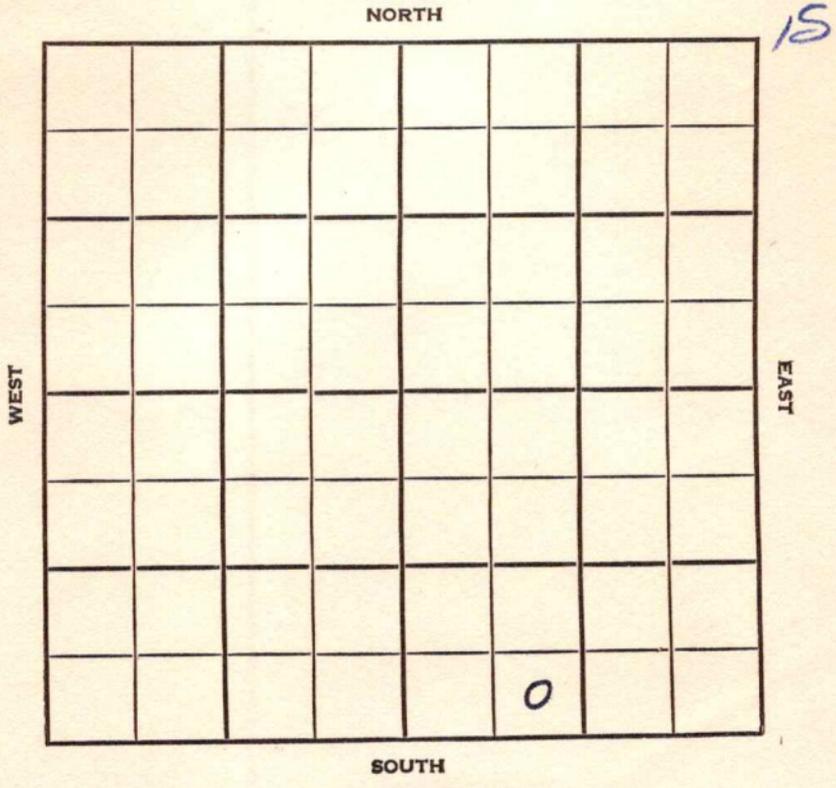

Barber KANSAS


SEC.	TWP.	R.
17	33	11W
WELL NO.		
3 W. A. Newkirk		
FARM		
COMPANY		
Gulf Oil		
CONTRACTOR		
Barbour		

\_\_\_\_\_ Ft. from N. Line

330 \_\_\_\_\_ Ft. from S. Line

\_\_\_\_\_ Ft. from E. Line

1040 \_\_\_\_\_ Ft. from W. Line

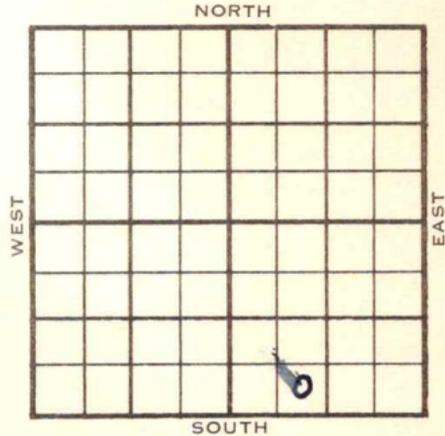

SE SW SE

	ELEVATION	REPORT
1954	1399'	
7/21-	Spd 7-14-54	
9/22	Spud 7-17-54 - Oil Well	
	TD 4600'	
	8" @ 215'	
	Anhy 1575', Heeb 3567', Doug 3661',	
	Br.lime 3725', Jans 3755', Miss 4426'	
	DST 4497-4540', opn 1 hr., rec. 300'	
	gas, 60' O&GCM, 239#	
	DST 4422-63', opn 1 hr., rec. 20'	
	SOCM, <del>100</del> 140#	
	DST 4469-4500', opn 1 hr., rec. 90' gas	
	50' SOCM, 72#	
	TD 4600'	
	5" @ 4592'	
	CO to 4600'	
	88/4472-94, frac	
	S&F/199 bo 1 1/2% wtr.	
	F/45 bo 1% wtr. 4 hrs.	
	F/6 bo 1% wtr. 1 hr.	
	C omp. 252 bopd	

COMPLETED



