

Barber KANSAS

Section 17 Township 33 Range 11WWell No. 6 W. A. NewkirkCompany Gulf Oil Corp.

NORTH

16

							0

SOUTH

WEST

EAST

SEC.	TWP.	R.
17	33	11W

WELL NO.

6 W. A. Newkirk

FARM

COMPANY

Gulf Oil Corp.

CONTRACTOR

Barbour Tools


Rhodes Pool

_____ Ft. from N. Line

330 _____ Ft. from S. Line

330 _____ Ft. from E. Line

_____ Ft. from W. Line

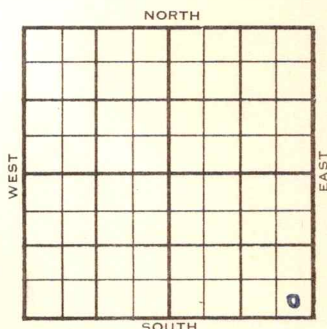

SE SE SE

1954	ELEVATION 1431'	REPORT
------	--------------------	--------

9/22 Spud 9-19-54
8" @ 208' w/150 WOC

11/10 Spud 9-19-54
Oil Well
TD 4603'
8" @ 208'
Heeb 3590', Doug 3711', Br. Lime 3782'
Lans 3792', Miss 4455'
Schl Tops: Heeb 3591', Doug 3711',
Br. Lime 3783', Lans 3790', Miss 4455'
5" @ 4603'
TD 4603'
120/ 4500-30 S/ $\frac{1}{2}$ boph 6 hr.
420 A F/ 195 bo 6 hr.
Comp. F/ 502 bopd

COMPLETED

County **Barber** State **Kansas**

Sec. **17** (Blk. **33** (Sur. **11W** Map No. **11W**)
(Twp.) (Rge.)

Operator Gulf Oil Corp.

Well No. 6 Farm W. A. Newkirk

Elev.	Location	SE SE SE

[illegible]

330 Ft. From S Line SE

330 Ft. From E Line Quarter

1st. Report SEP 22 1954

Completion

Remarks

Barbour Tools

Spudding Date 9/19/54

Drlg. Data **Rhodes Pool**

8" @ 208 w/150 WOC

FABEN GILSTRAP

County **Barber** State **Kansas**Sec. **17** (Blk. **33** (Sur. **11W** Map No.Operator **Gulf Oil Corp.**Well No. **6** Farm **W. A. Newkirk**Elev. **1431** Location **SE SE SE****330** Ft. From **S** Line **SE****330** Ft. From **E** Line **Quarter**

1st. Report

Completion **NOV 10 1954**Remarks **Rhodes Pool****Barbour - Contr.**Spudding Date **9-19-54**Drlg. Data **Oil well** **TD 4603****8" @ 208** **Heeb. 3590** **Doug. 3711****Br. lime 3782** **Lans. 3792** **Miss. 4455****SCHLUMBERGER TOPS:****Heeb. 3591** **Doug. 3711** **Br. lime 3783****Lans. 3790** **Miss. 4455** **5" @ 4603****TD 4603** **120/ 4500-30** **S/ $\frac{1}{2}$ boph****6 hr.** **420 A** **F/ 195 bo** **6 hr.****Comp. F/ 502 bopd**

FABEN GILSTRAP