


Section 18 Township 33 Range 11 W

Well No. # 2 Fitzgerald

Company M. B. Armer

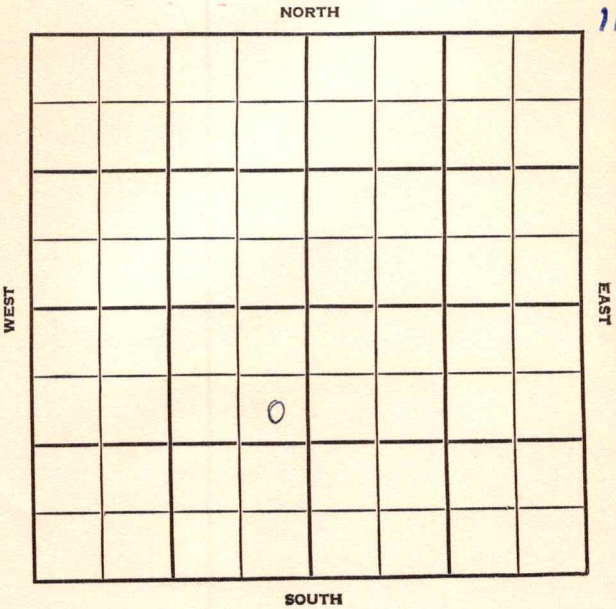

SEC.	TWP.	R.
18	33	11W

WELL NO.

2 Fitzgerald

FARM

COMPANY

M. B. Armer

CONTRACTOR

Armer

Semi-Wildcat

990


Ft. from N. Line

Ft. from S. Line

330

Ft. from E. Line

Ft. from W. Line

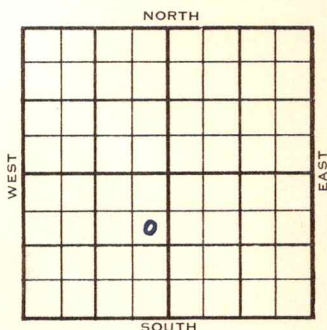

SE NE SW

Skelly DHM

1954

ELEVATION

1391' RB - 1388' DP

REPORT

10/13

Spud 10-5-54

8" @ 204'

Anhy 855'

Drlg. 3295'

11/3

Spud 10-5-54 - D&A

TD 4505'

8" @ 204'

Anhy 855', Elgin 3393', Heeb 3551',

Doug. 3654'

DST 3652-63', opn 1 1/4 hrs., rec. 495'

SW, 0#

Miss. chert 4406'

DST 4415-49', opn 2 hrs., gas in 20",

rec. 150' gcm, 748#

DST 4450-76', opn 2 hrs., rec. 540'

gas, 110' gcm, 60' wtry mud, 343#

TD 4505'

Schl Tops: Heeb 3542', Tor 3575',

Doug. 3652', Lans 3738', Miss 4410'

Perf 4430-42, frac.

S/2 bfph 75% wtr. 8 hrs.

D&A


ABANDONED

County Barber State Kansas
 Sec. 18 (Blk.) 33 (Sur.) 11W Map No.

Operator M. B. Armer

Well No. 2 Farm Fitzgerald

Elev. 1391 RB
1388 DF Location SE NE SW

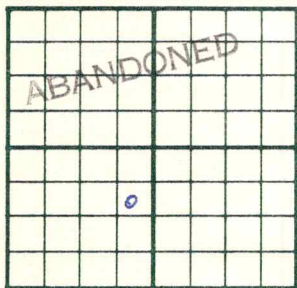

990 Ft. From N Line SW

330 Ft. From E Line Quarter

1st. Report

Completion NOV 3 1954

Remarks Semi Wildcat

Armer - Contr.

Spudding Date 10-5-54

Drlg. Data D & A TD 4505

8" @ 204 Anhy 855 Elgin 3393

Heeb. 3551 Doug. 3654 DST 3652-63

open 1 $\frac{1}{4}$ hr. Rec. 495' sw 0#

Miss. chert 4406 DST 4415-49 open 2 hr

gas in 20 min. Rec. 150' gcm 748#

DST 4450-76 open 2 hr. Rec. 540' gas

110' gcm 60' wtry mud 343# TD 4505

SCHLUMBERGER TOPS

Heeb. 3542 Tor. 3575 Doug. 3652

Lans. 3738 Miss. 4410 perf/ 4430-42

frac S/ 2 bfph 75% wtr. 8 hr.

D & A

FABEN GILSTRAP

FABEN GILSTRAP