


Section 17 Township 33 Range 11W

Well No. #13 W.A. Newkirk

Company Gulf Oil

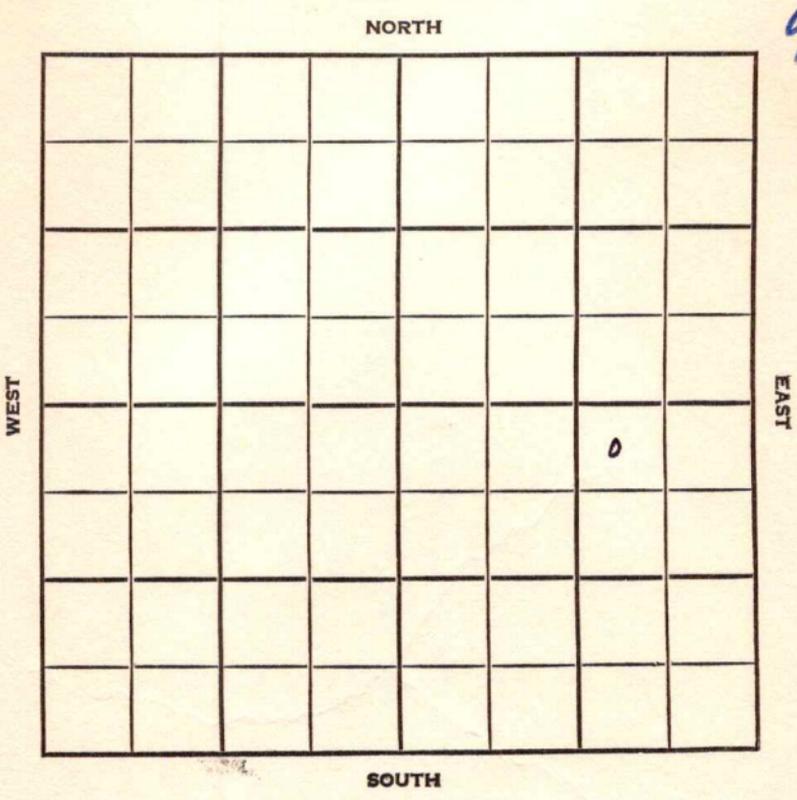


SEC.	TWP.	R.
17	33	11W

WELL NO. #13 W.A. Newkirk FARM

COMPANY Gulf Oil

CONTRACTOR G-M-R

Rhodes Pool
 330 Ft. from N. Line
 _____ Ft. from S. Line
 990 Ft. from E. Line
 _____ Ft. from W. Line

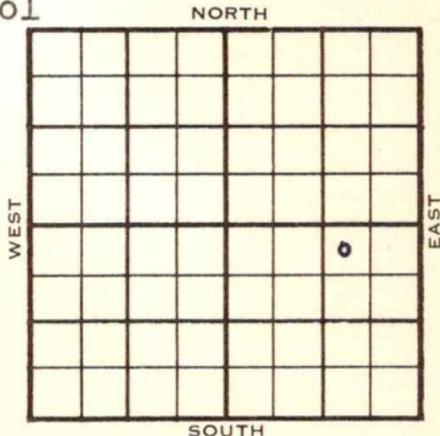

NW NE SE

	ELEVATION	REPORT
1955	1433'	

3/9

Location

5/25

Heeb 3588; Doug 3696; Br Ls 3781;
 Lsg 3787; Miss 4468;
 TD 4597; 8 5/8" 222; RTM 4597;
 5 1/2" 4569; CO 4538; 80/4510-30,
 bail 1 goph plus 1 1/2 gwph 12 hrs; 400 A
 frac; swb 96 bf 30% wtr 23 hrs; swb 44
 of 22% wtr 5 hrs; Phy pmp 303 bopd
 plus 4% wtr. from Miss 4510-30

COMPLETED

