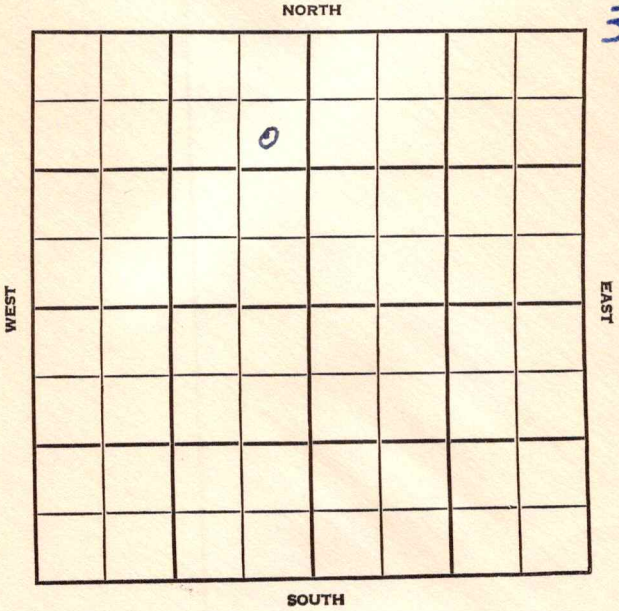


Section 20 Township 33 Range 11WWell No. 17 NewkirkCompany Continental Oil

Barber

KANSAS

SEC.	TWP.	R.
20	33	11W

WELL NO.

#17 Newkirk

FARM

COMPANY

Continental Oil

CONTRACTOR

Noble Drlg.

Rhodes Pool

990


Ft. from N. Line

Ft. from S. Line

330

Ft. from E. Line

Ft. from W. Line

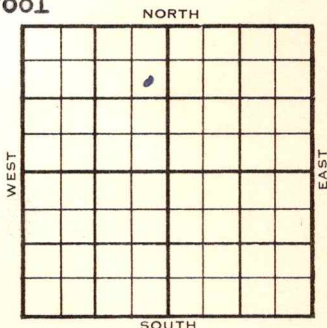

SE NE NW

1955

ELEVATION

1383'

REPORT

2/16

Spud 2-12-55

8" @ 269'

Drlg. 2385'

4/6

Spud 2-12-55 - Oil Well

TD 4591'

8" @ 269'

Lgin 3424', Heeb. 3578', Lans 3740',

Miss. 4416'

5" @ 4591'

CO to 4556', 96/4490-4514, frac

F/39 bo 12 bw 5 hrs.

S&F/71 bo 18 bw 8 hrs.

F/22 bo 5 bw 5 hrs.

P/44 bo 15 bw 8 hrs.

Comp. 132 bopd 45 bw

COMPLETED

County Barber State Kansas
 Sec. 20 (Blk.) 33 (Sur.) 11W Map No.
 Operator Continental Oil
 Well No. 17 Farm Newkirk
 Elev. 1383 Location SE NE NW



990 Ft. From N Line NW
330 Ft. From E Line Quarter

1st. Report

Completion APR 6 1955

Remarks Rhodes Pool

Noble Drlg. - Contr.

Spudding Date 2-12-55

Drlg. Data Oil well TD 4591

8" @ 269 Elgin 3424 Heeb. 3578

Lans. 3740 Miss. 4416 5" @ 4591

C0 to 4556 96/ 4490-4514 frac

F/ 39 bo 12 bw 5 hr. S & F/ 71 bo

18 bw 8 hr. F/ 22 bo 5 bw 5 hr.

P/ 44 bo 15 bw 8 hr.

Comp. 132 bopd 45 bw

FABEN GILSTRAP