

DX 78-1

Barber

KANSAS

20

33

11 W

Section _____ Township _____ Range _____

Well No. # 15 Newkirk

Company Continental Oil

NORTH

WEST

EAST

0							

SOUTH

5

Barber

KANSAS

SEC.	TWP.	R.
20	33	11W

WELL NO.

#15 Newkirk FARM

COMPANY

Continental Oil

CONTRACTOR

Noble Drlg.

Rhodes Pool

Ft. from N. Line

990


Ft. from S. Line

Ft. from E. Line

330

Ft. from W. Line

NW SW NW

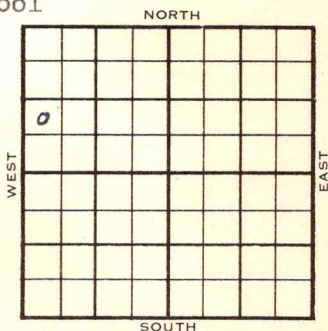

1955	ELEVATION	REPORT
	1383'	

2/2

Spud 1-29-55

8" @ 271'

Drlg. 2050'

4/6

Spud 1-29-55 - Oil Well

TD 4590'

8" @ 271'

Heeb. 3573', Lans. 3755', Miss 4426'

TD 4590'

5" @ 4590',

CO to 4565'

80/4534-54,

d-frac, S/56 bo 22 bw 5 hrs.,

SI 48 hrs.

F/1½ bo 20", 104/4500-26, SP 4529,

frac, S/49 bo 19 bw 5 hrs.

P/42 bo 12 bw 8 hrs.

Comp. 126 bopd 36 bw

COMPLETED

County **Barber** State **Kansas**Sec. **20** (Blk.) **33** (Sur.) **11W** Map No.Operator **Continental Oil**Well No. **15** Farm **Newkirk**Elev. **1383** Location **NW SW NW**

990 Ft. From **S** Line **NW****330** Ft. From **W** Line Quarter1st. Report **FEB 2 1955**

Completion

Remarks

Noble Drlg. - Contr.Spudding Date **1-29-55**Drlg. Data **Rhodes Pool****8" @ 271 drlg. 2050**

FABEN GILSTRAP

County Barber State Kansas
 Sec. 20 (Blk. 33 (Sur. 11W Map No.)
 (Twp.) (Rge.)
 Operator Continental Oil
 Well No. 15 Farm Newkirk
 Elev. 1383 Location NW SW NW

0							

990 Ft. From S Line NW
330 Ft. From W Line Quarter
 1st. Report
 Completion APR 6 1955
 Remarks Rhodes Pool
Noble Drlg. - Contr.
 Spudding Date 1-29-55

Drlg. Data Oil well TD 4590
8" @ 271 Heeb. 3573 Lans. 3755
Miss. 4426 TD 4590 5" @ 4590 CO to
4565 80/ 4534-54 sd-frac S/ 56 bo 22
bw 5 hr. SI 48 hr. F/ 1 $\frac{1}{2}$ bo 20 min.
104/ 4500-26 SP 4529 frac S/ 49 bo
19 bw 5 hr. P/ 42 bo 12 bw 8 hr.
Comp. 126 bopd 36 bw

HABEN GILSTRAP