


Barber

KANSAS

SECTION 3 TOWNSHIP 33 RANGE 11W

WELL NO. #1 C.D. Williams

COMPANY Gulf Oil

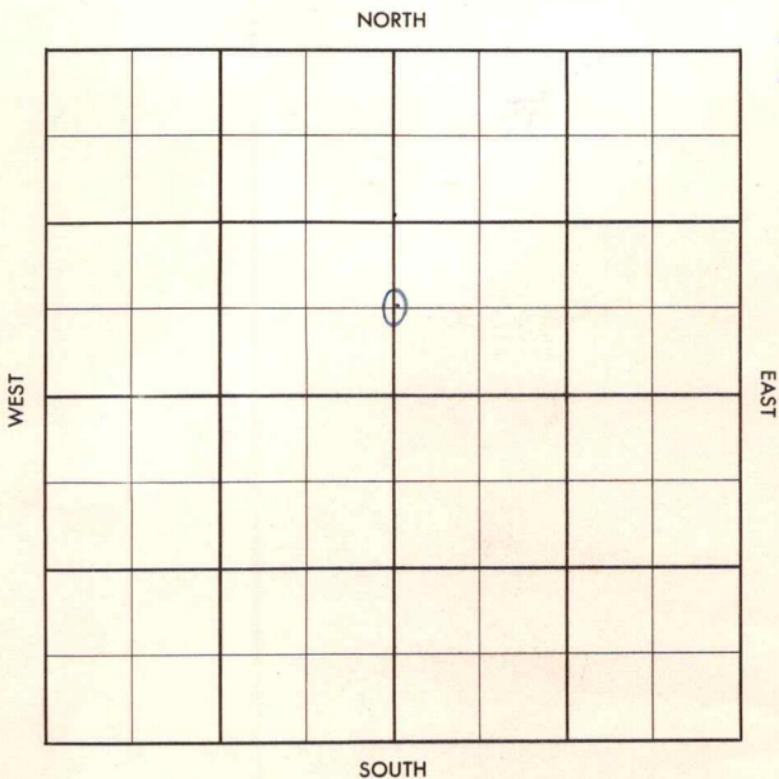

Barber

KANSAS


SEC.	TWP.	R.
3	33	11W

WELL NO. #1 C. D. Williams FARM

COMPANY Gulf Oil

CONTRACTOR Barber Rhoades

_____ FT. FROM N. LINE
 _____ FT. FROM S. LINE
 _____ FT. FROM E. LINE
 _____ FT. FROM W. LINE

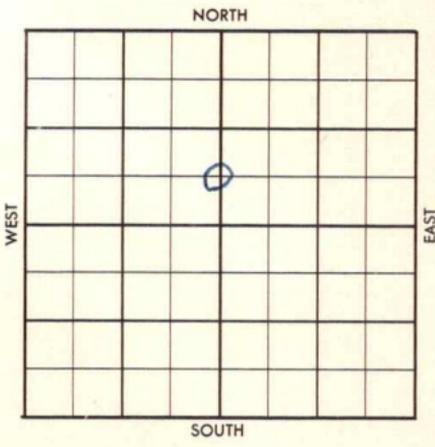

C S $\frac{1}{2}$ N $\frac{1}{2}$

SDX Lease 1/4 mi

1956	ELEVATION	REPORT
------	-----------	--------

9-5
 Comm 8-3-56
 8" @ 278 w/250
 Drlg 690

County Barber Elev. _____
 Sec. 3 Twp. 33 Rge. 11W
 Company Gulf Oil
 Farm Name C. D. Williams No. 1

TOPS	DEPTH	LOG	DATUM
Anh.			
Tp.			
H.			
Tr.			
Dg.			
Bl.			
L.			
K.C.			
B.K.C.			
Ce.			
C.			
M.			
M.			
K.			
Mz.			
Mo.			
V.			
S.			
S.			
A.			
R.			
PE.			
G.			
T.D.			

Loc. in Sec. C S $\frac{1}{2}$ N $\frac{1}{2}$
 Geol. _____
 Contr. Barber
 Pool Rhoades
1/4 mile
 FIRST REPORT
 SEP 5 1956

Date Comm. 8-3-56
8" @ 278/250 drlg. 690

~~26~~
 214.34
 6201 1 1 932

Co.
Lse.
T.
R.

Co.

County Barber Elev. 1532
 Sec. 3 Twp. 33 Rgs. 11W
 Company Gulf Oil
 Farm Name C. D. Williams No. 1

	DEPTH	LOG	DATUM	Loc. in Sec.
H.	3611			C S ¹ N ¹
Tr.				
Dg.	3734			Geol. _____ Contr. _____ Barber Pool Rhoades COMPLETE 44 miles
Bj.	3796			
L.	3802			
K.C.				
B.K.C.				
Ce.				
C.				
M.	chert 4461			
M.	LI 4513			
K.				
Mz.				
Mo.				
V.				
S.				
S.				
A.				
R.				
PE.				
G.				
T.D.	4590			

Loc.

No.

Sec.

T.

R.

Date Comm. 8-3-56 OCT 10 1956

8" @ 278/250 drlg. 690 SEP 12 '56 3642
 SEP 19 '56 DST 4460-93 25" G/2 1/2"
 ga 1.200 MCF/7" 1.630 MCF/11"
 1.930 MCF/15" stabil. SEP 26 '56
 rec 670' GCM FP 555 BHP
 1470/30" 4 1/2 @ 4589/125
 PB 4555 PF fail PB 4525 104/4464
 -90 (1) Flw 63 B0 + 9 B acid
 wtu in 9 hrs + 100 MCF G 1" ch
 TP 50 CP 100 OCT 3 '56

Frac Flwg Ld + 7,220

MCF 35/64" ch CP 1180

OCT 10 '56

cal op Flw 8,200

MCFGPD.