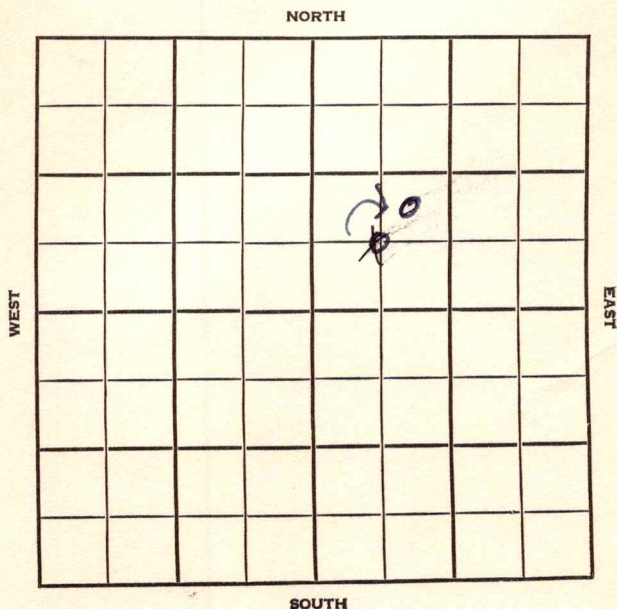


Section 9 Township 33 Range 11W
Well No. 1 Colborn "A"
Company Sinclair



Barber

KANSAS

SEC.	TWP.	R.
9	33	11W

WELL NO.

#1 Colborn "A"

FARM

COMPANY

Sinclair

CONTRACTOR

Adkins

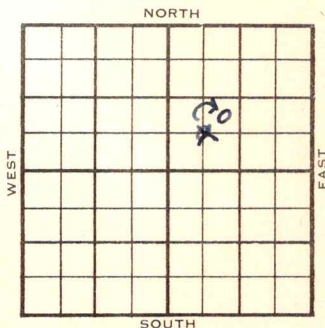
Wildcat.

Ft. from N. Line

Ft. from S. Line

Ft. from E. Line

Ft. from W. Line

NE
G SW NE

1955

ELEVATION

1448'

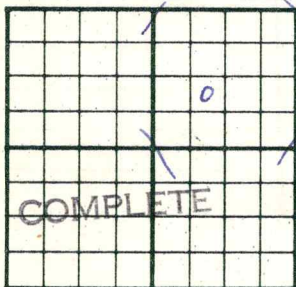
REPORT

1/19
3/23

Location

Spud 1-22-55, gas well, TD 4536
 10 3/4" @ 2 50, Doug 3667
 DST 3667-84, open 1 hr, Rec
 1575' SW, 1475#, Lans 3730,
 Miss 4387, DST 4381-4423, open
 1 hr 40 min. gas in 8 min.
 1,710,000 CFG in 38 min. 0#
 TD 4536, 5" @ 4535, CO to 4500
 152/4422-60, 3,310,000 CFG in
 8 hrs
 Comp 7 to 8 MCFGPD

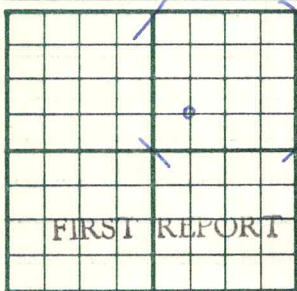
COMPLETED

County Barber State KansasSec. 9 (Blk. 33 (Sur. 11W Map No. Map No.)
(Twp.) (Rge.)Operator SinclairWell No. 1 Farm Colborn "A"Elev. 1448 Location NE SW NE990 Ft. From S Line NE990 Ft. From W Line Quarter1st. Report MAR 23 1955

Completion

Remarks WildcatAdkins - Contr.Spudding Date 1-22-55Drlg. Data Gas well TD 453610 3/4" @ 250 Doug. 3667 DST 3667-84open 1 hr. Rec. 1575' sw 1475#Lans. 3730 Miss. 4387 DST 4381-4423open 1 hr. 40 min. gas in 8 min.1,710,000 cfg in 38 min. 0#TD 4536 5" @ 4535 CO to 4500152/ 4422-60 3,310,000 cfg 8 hr.Comp. 7 to 8 mcf/gpd

FABEN GILSTRAP

County **Barber** State **Kansas**Sec. **9** (Blk.) **33** (Sur.) **11W** Map No.Operator **Sinclair**Well No. **1** Farm **Colborn "A"**Elev. Location **C SW NE****660** Ft. From **S** Line **NE****660** Ft. From **W** Line Quarter1st. Report **JAN 19 1955**

Completion

Remarks

Adkins - Contr.

Spudding Date

Drlg. Data **Wildcat****Location**

FABEN GILSTRAP

SCOUT TICKET

DX-201

Kansas

SEC.

9

TWP.

33

R.

11W

WELL NO.

1 Colborn "A"

FARM

COMPANY

Sinclair

CONTRACTOR

CORRECTION

NE SW NE

____ FT. FROM N. LINE

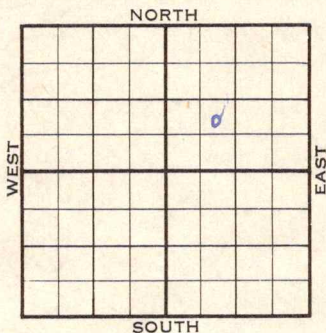
990

____ FT. FROM S. LINE

____ FT. FORM E. LINE

990

____ FT. FROM W. LINE



Barber County

☐

LOCATION

☐

RIG UP

DRILLING AND REMARKS:

Reported

C SW NE

RECORD

CASED IN., FT.

SAND

GAS

OIL

TOTAL DEPTH

PRODUCTION

1ST 24 HRS. NAT.

1ST 24 HRS. AFTER SHOT

GAS CU. FT.

DRY HOLE

ABANDONED

DATE

FEB 2 1955

SCOUT

FABEN GILSTRAP