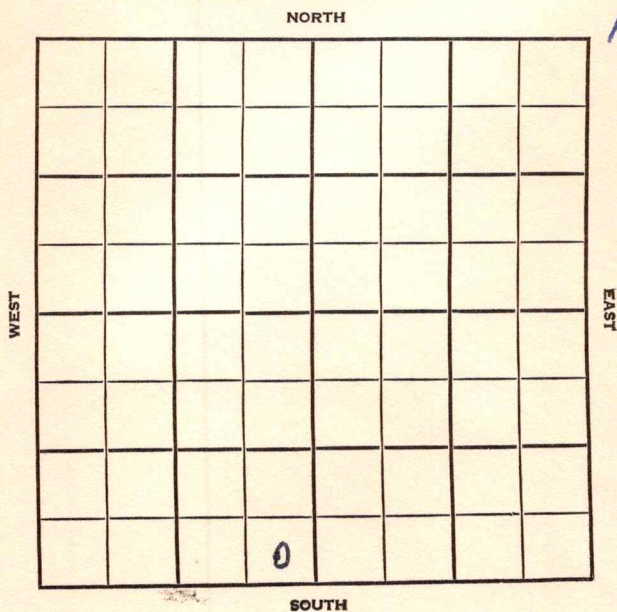



Section 4 Township 33 Range 11WWell No. 1 EarlyCompany Musgrove Petr.

Barber KANSAS ✓
 SEC. TWP. R.
 4 33 11W
 WELL NO.
 COMPANY 1 Early FARM
 CONTRACTOR Musgrove Pet.

Musgrove Contr.
 Wildcat NORTH
 Ft. from N. Line
 330 Ft. from S. Line
 330 Ft. from E. Line
 Ft. from W. Line
 SE S^E SW
 WEST EAST
 SOUTH

	ELEVATION	REPORT
1954	1481'	
6/2	R U R	
6/9	8" @ 230' w/175 sks	
6/23	Drlg. 2840'	
7/28	Drlg. 4770'	
	Spud 6-2-54 - Gas Well	
	TD 4893'	
	8" @ 230'	
	Heeb 3570', Doug 3700'	
	DST 3703-35, opn 1/4 hrs., rec. 4,260,000	
	gas, spray sw in 9", 150' sw, 1420#	
	Lans 3776'	
	DST 3783-3830', opn 1 hr., rec. 50'	
	mud, 1540# B KC 4258', Miss 4418'	
	DST 4415-50', opn 1 hr., 2,190,000 gas,	
	130' gcm, 1580#	
	Kh. 4582', Viola 4738', Simp 4828',	
	Simp. sd 4878'	
	DST 4842-60', opn 1 hr., rec. 700' sw,	
	1845#	
	Arb. 4954'	
	TD 4983'	
	5" @ 4600	
	CO to 4561, 105/4423-58, frx A-frac	
	1,980,000 gas	
	Comp. 8,256,000 cfcpd	
	COMPLETED	

County Barber State Kansas
 Sec. 4 (Blk.) 33 (Sur.) 11W Map No.
 Operator Musgrove Pet.
 Well No. 1 Farm Early
 Elev. 1481 Location SE SE SW

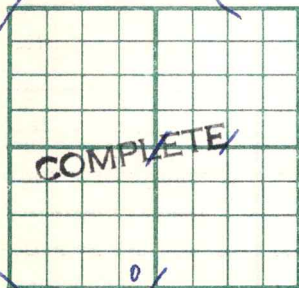

330 Ft. From S Line SW
330 Ft. From E Line Quarter

1st. Report

Completion JUL 28 1954

Remarks Wildcat

Musgrove - Contr.

Spudding Date 6-2-54

Drilg. Data Gas well TD 4983

8" @ 230 Heeb. 3570 Doug. 3700

DST 3703-35 open $\frac{1}{4}$ hr. Rec. 4,260,000

gas spray sw in 9 min. 150' sw 1420#

Lans. 3776 DST 3783-3830 open 1 hr.

Rec. 50' mud 1540# B KC 4258

Miss. 4418 DST 4415-50 open 1 hr.

2,190,000 gas 130' gcm 1580#

Kh. 4582 Viola 4738 Simp. 4828

Simp. sd. 4878 DST 4842-60 open 1 hr.

Rec. 700' sw 1845# Arb. 4954

TD 4983 5" @ 4600 CO to 4561

105/ 4423-58 A-frac 1,980,000 gas

Comp. 8,256,000 cfcpd

J. G. McGEHEE

