

Barber


DX 78-1

KANSAS

Section 5 Township 33 Range 11W

Well No. #1 Gray

Company O.A. Sutton

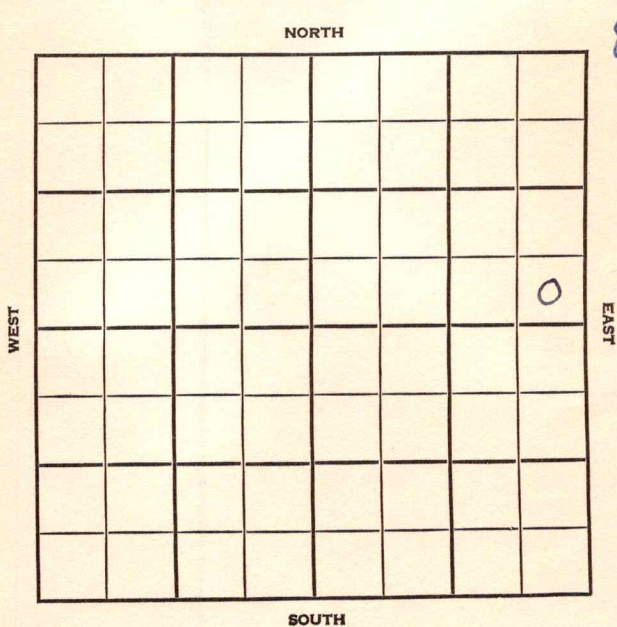

D arber

KANSAS

SEC.	TWP.	R.
5	33	11W

WELL NO.

#1 Gray

FARM

COMPANY

O.A. Sutton

CONTRACTOR

Jackson

NW Rhodes Pool

NORTH

Ft. from N. Line


330

Ft. from S. Line

330

Ft. from E. Line

Ft. from W. Line

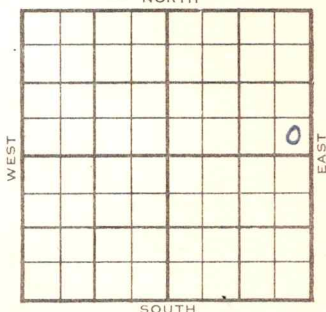

SE SE NE

Magnolia F/O

1955

ELEVATION

1448'

REPORT

4/6

Spud 4-1-55

8" @ 245

Drlg. 2019'

5/25

Spud 4-1-55

8" @ 245 w/200

DST 3680-95 open $\frac{1}{2}$ hr, gas to surface
in 2 min, 4,900 MCFG in $\frac{1}{2}$ hr. rec
100' SW 1365/15"

DST 3666-80 open 1 hr, rec 740' SW

1345# 5 $\frac{1}{2}$ " @ 3735 12/3666-69

Comp. 2,500 MCFGPD

Elgin 3476', Doug. 3665'

TD 3745'

COMPLETED

FABEN GILSTRAP

COMPLETED

FORM 513 REV. SUNRAY

County Barber Elev. 1448
 Sec. 5 Twp. 33 Rge. 11W
 Company O. A. Sutton
 Farm Name Gray No. 1

TOPS	DEPTH	DATUM
Cim. Anhydrite		
Ft. Riley <u>Elgin</u>	<u>3476</u>	<u>2028</u>
Howard		
Topeka		
Heebner Sh.		
Toronto Ls.		
Brown Lime		
Lansing <u>Doug.</u>	<u>3665</u>	<u>2217</u>
Kans. City		
B. K. C.		
Congl.		
Miss.		
Kinderhook		
Misener		
Hunton		
Sylv. Maquo		
Viola		
Simpson		
Smp.		
Gorham		
Arbuckle		
Basal Sand		
Pre. Cam.		
T. D.	<u>3745</u>	

Loc. in Section

SE SE NEDrlg. Contr. JacksonPool NW Rhodes

Date Comm.

Date Comp. MAY 25 '55Spud 4-1-55 8" @ 245 w/ 200DST 3680-95 open $\frac{1}{2}$ hr. gas to sur face
in 2 min. 4,900 mcf g in $\frac{1}{2}$ hr. Rec.100' sw 1365/15" DST 3666-80 open1 hr. Rec. 740' sw 1345#5 $\frac{1}{2}$ " @ 3735 12/ 3666-69Comp. 2,500 mcf gpd