

Barber

KANSAS


SECTION 10 TOWNSHIP 33 RANGE 11 W

WELL NO. #1 Colburn

COMPANY Amerada Pet.

NORTH

12

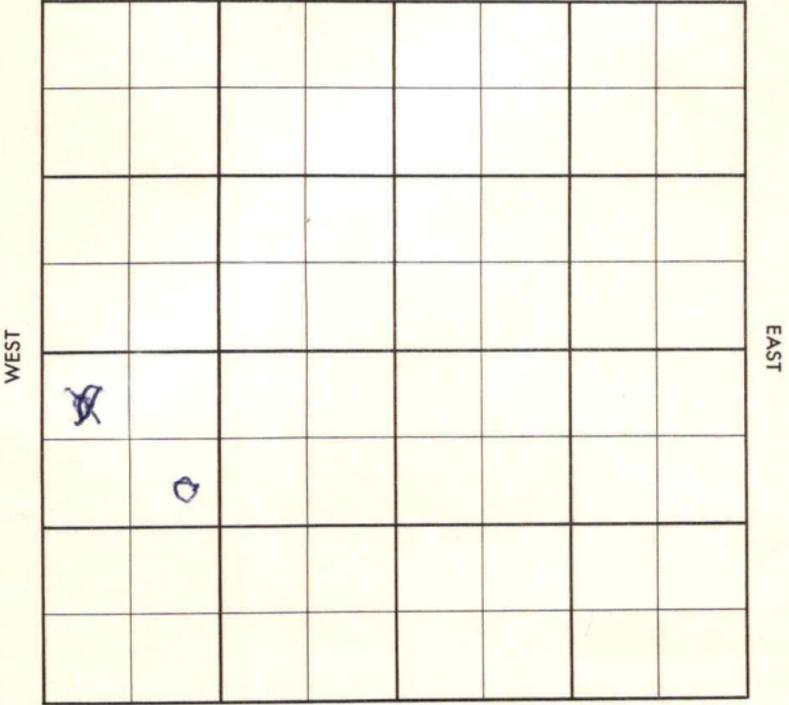

SOUTH

SEC.	TWP.	R.
10	33	11W

WELL NO.

#1 Colburn

FARM

COMPANY

Amerada Petr.

CONTRACTOR

Barbour

N. Rhodes


Ft. from N. Line

Ft. from S. Line

Ft. from E. Line

Ft. from W. Line

SE NW SW

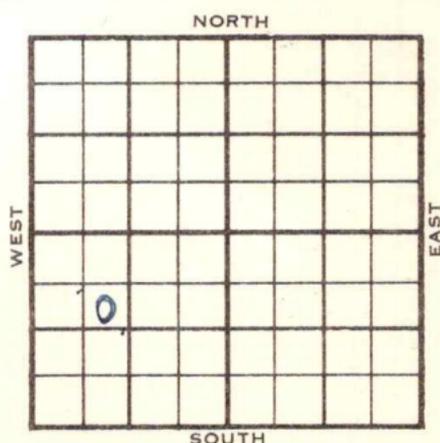

	ELEVATION	REPORT
1956	1489	
3-7	MIR	
4-18	Comm. 3-9-56 8 5/8" @ 307 w/300 DST 3711-19 op 2 hrs. rec. 1339' sw, 1305/20" DST 4484-4525 op 1 hr. gas in 2 min. 2310 mcfg in 5 min. rec. 178' gcm, 665/20" DST 4526-70 op 1 hr. gas in 1 1/2 min. 1790 mcfg in 8 min. rec. 268' ho&gcm, 1710/20" 5 1/2" @ 4623/1250 CO to 4590 160/ 4516-68, 1000 A, 1450 mcfg, frac 3595 mcfg, 5210 mcfg Comp. open flow 7902 mcfgpd. H. 3593 Tr. 3615 Dg. 3624 Dg sd. 3710 Br. L. 3800 Lans. 3806 M. 4480 Rework 4475 M. 1m 4496 Kd 4597 TD 4625	

County Barber Elev. 1489  
 Sec. 10 Twp. 33 Rge. 11W  
 Company Amerada Pet.  
 Farm Name Colburn No. 1

TOPS	DEPTH	LOG	DATUM	Loc. in Sec.
Anh.				SE NW SW
TP.				
H.	3593			
Tr.	3615			
Dg.	3624			
Bl. <i>Dg. sd.</i>	3710		2221	
L. <i>Bl. l.</i>	3800		2311	Geol.
K.C. <i>Lans</i>	3806		2317	Contr.
B.K.C.				Barbour
Ce.				
C.				
M.	4480		2991	Pool
M. <i>Remark</i>	4475		2986	N. Rhodes
K. <i>M. l.w</i>	4496		3007	
Mz. <i>Kd</i>	4597		3108	
Mq.				
V.				
S.				
S.				
A				
R.				
PE.				
G.				
T.D.	4625			

COMPLETE

Date Comm. 3-9-56 APR 18 1956

8 5/8" @ 307/300 DST 3711-19  
 open 2 hr. rec. 1339' sw 1305/20"  
 DST 4484-4525 open 1/2 hr. gas in 2 min.  
 2,310 mcfg in 5 min. rec. 178' gcm  
 665/20" DST 4526-70 open 1 hr.  
 gas in 1 1/2 min. 1,790 mcfg in 8 min.  
 rec. 268' ho & gcm 1710/20"  
 5 1/2" @ 4623/1250 CO to 4590

OVER

168/ 4516-68 1000 A 1,450 mcfg

frac 3,595 mcfg 5,210 mcfg

Comp. open flow 7,902 mcfgpd

R. G.

APR 26 1956

County **Barber** Elev. \_\_\_\_\_  
 Sec. **10** Twp. **33** Rge. **11W**  
 Company **Amerada Pet,**  
 Farm Name **Colburn** No. **1**

TOPS	DEPTH	LOG	DATUM	Loc. in Sec.
Anh.				SE NW SW
T.P.				
H.				
Tr.				
Dg.				
Bl.				
L.				Geol. _____
K.C.				Contr. _____
B.K.C.				Ba rbour
Ce.				
C.				Pool _____
M.				N. Rhodes
M.				
K.				
Mz.				
Mq.				
V.				
S.				
S.				
A				
R.				
PE.				
G.				
T.D.				

FIRST REPORT  
 MAR 7 1956

Date Comm.  
**M I R**

*[Handwritten signature]*

Co.  
 Lse.  
 No.  
 Sec.  
 T.  
 R.