

Section 11 Township 33 Range 11WWell No. #1 Lloyd DavisCompany Magnolia Pet.

NORTH

16

WEST

EAST

							0

SOUTH

Barber

KANSAS

SEC.	TWP.	R.
11	33	11W

WELL NO.

#1 Lloyd Davis

FARM

COMPANY

Magnolia Pet.

CONTRACTOR

Barnett

Wildcat

Ft. from N. Line


330

Ft. from S. Line

330

Ft. from E. Line

Ft. from W. Line

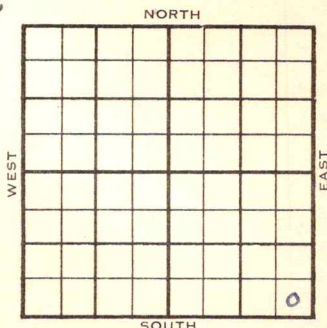

SE SE SE

Sinc. & Amer. support.

	ELEVATION	REPORT
1954	1484'	

Arb Test.

2/17 Location

2/24 13" @ 480' w/600 sks

Drlg 800'

3/3 Drlg 3015'

3/10 Elgin Sd 3457'

DST 3466'-96' 1 hr, 55' M O#

Doug 3684'

DST 3682'-94' 1 hr, 360' SW 1285#

Lans 3780'

Drlg 3860'

3/17 Miss 4460'

Drlg 4487'

3/24 V 4801', Simp Sho 4896', Simp 4918'

Drlg 4935'

OVER

1954

3/31

Spud 2-18-54 D & A TD 5100'

13" @ 480 **Elgin sd 3457**

DST 3466-96 open 1 hr rec 55' mud 0#

Doug. 3684

DST 3682-94 open 1 hr rec 360' SW

1285# **Lans. 3780 Miss 4460**

Viola 4801 Simp. 4896 Simp sd 4918

Arb. 5043 TD 5100'

D & A

ABANDONED

County Barber State KansasSec. 11 (Blk.
Twp.) 33 (Sur.
Rge.) 11W Map No.Operator Magnolia Pet.Well No. 1 Farm Lloyd DavisElev. 1484 Location SE SE SE330 Ft. From S Line SE330 Ft. From E Line Quarter

1st. Report

Completion MAR 31 1954Remarks WildcatBarnett - Contr.Spudding Date 2-18-54Drlg. Data D & A TD 510013" @ 480 Elgin sd. 3457 DST 3466-96open 1 hr. Rec. 55' mud 0# Doug. 3684DST 3682-94 open 1 hr. Rec. 360' sw1285# Lans. 3780 Miss. 4460Viola 4801 Simp. 4896 Simp. sd. 4918Arb. 5043 TD 5100D & A

J. G. McGEHEE

County Barber State Kansas

Sec. 11 (Blk. Twp.) 33 (Sur. Rge.) 11W Map No.

Operator Magnolia Pet.

Well No. 1 Farm Lloyd Davis

[illegible]

FIRST REPORT

0

330 Ft. From S Line SE

330 Ft. From E Line Quarter

1st. Report FEB 17 1954

Completion

Remarks ^{Arb. test}
Sinc. & Amer. suppo

Barnett - Contr.

Spudding Date _____

Drlg. Data Wildcat

Location

J. G. McGEHEE