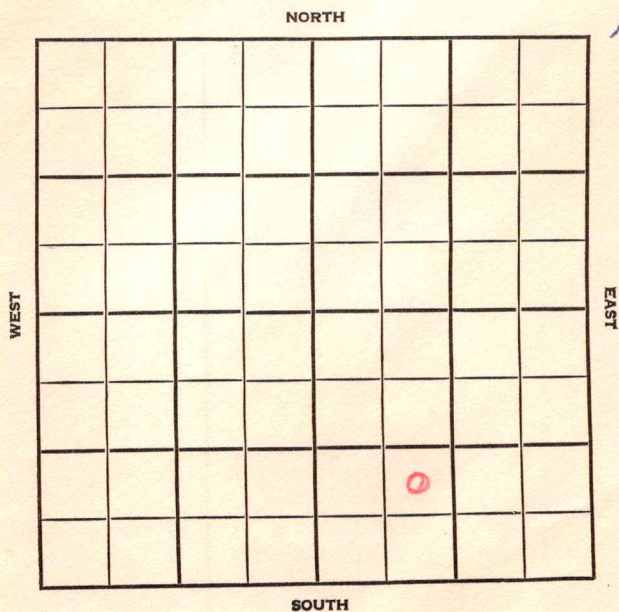


Barber

KANSAS

Section 4 Township 33 Range 11WWell No. #1 Colborn "B"Company Sinclair O & G

Barber

HOT FILE

KANSAS

SEC.

TWP.

R.

4

33

11w

WELL NO.

1 Colborn "B"

FARM

COMPANY

Sinclair O & G

CONTRACTOR

N. Rhodes Pool

Ft. from N. Line


990'

Ft. from S. Line

Ft. from E. Line

990'

Ft. from W. Line

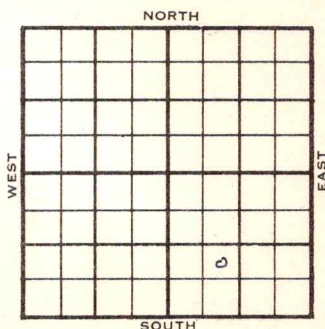

NE SW SE

1/2 mile west Sunray Mid-Continent Acreage

1955

ELEVATION

1493'

REPORT

5/25

Location

6/2

Spud 5-28-55

Drlg. 1925'

6/9

Heeb 3574' Doug 3580', Doug sd 3706'

Lans. 3768'

DST 3706-16, open 1 hr gge 7,120 MCFG

1445/30"

DST 3706-28, open 3 hr, gge 5,690 MCFG

rec 70' SW, 1475/30"

Drlg. 3910'

6/16

DST 4430-72, open 2 hr, gauge 1,250

MCFG, 1820/30". 5 1/2" @ 4574 w/175

TD 4578'

6/23

Waiting on orders.

6/30

PB 4541, 66/4511-22, 300 A, S/dry,

SP 4480, 36/4442-78, 300 A, S&F/

load plus 500 mcfg, frac, F/load,

9,485 mcfg.

7/7

Waiting on potential

7/14

Waiting on potential

7/20

Comp. 9,485 mcfcpd

Tops:	Depth	Log	Datum
H.	3574	3577	2084
Dg.	3580	3592	2099
B1 Doug sd	3706	3788	2215
L	3768	3770	2277

M.
TD. 4578

4428

2935

COMPLETED

County Barber Elev. 1493
 Sec. 4 Twp. 33 Rge. 11W
 Company Sinclair O & G
 Farm Name Colborne "B" No. 1

TOPS	DEPTH	LOG	DATUM	Loc. in Sec.
Anh.				NE SW SE
Tr.				
H.	<u>3574</u>	<u>3577</u>	<u>2084</u>	
Tr.				
Dg.	<u>3580</u>	<u>3592</u>	<u>2099</u>	
Bl.	<u>3706</u>	<u>3708</u>	<u>2221</u>	
L.	<u>3768</u>	<u>3770</u>	<u>2277</u>	
K.C.				Geol.
B.K.C.				Contr.
Ce.				
C.				
M.		<u>4428</u>	<u>2935</u>	
M.				Pool
K.				N. Rhodes
Mz.				
Mq.				
V.				
S.				
S.				
A.				
R.				
Pe.				
G.				
T.D.	<u>4578</u>			



Date Comm. 5-28-55 JUL 20 1955

DST 3706-16 open 1 hr. 7,120 mcf g

1445/30" DST 3706-26 open 3 hr.

Pa. 5,690 mcf g 70' sw 1475#

DST 4430-27 open 2 hr., 1,250 mcf g

1820/30" 5 $\frac{1}{2}$ " @ 4574 PB 4541

66/ 4511-22 300 A S/ dry SP 4480

36/ 4442-78 300 A S & F/ load

500 mcf g frac Comp. 9,485 mcf gpd

County Barber State Kansas

Sec. 4 (Blk. Twp.) 33 (Sur. Rge.) 11W Map No.

Operator Sinclair O & G

Well No. 1 Farm Colborn "B"

Elev.	Location	NE	SW	SE

FIRST REPORT

990 Ft. From S Line SE

990 Ft. From W Line Quarter

1st. Report MAY 25 1955

Completion

Remarks

Spudding Date _____

Drig. Data N. Rhodes Pool

Location _____

[Faint, illegible handwritten notes]

[illegible]

11/21/2010

1-40

