

DX 78-1

Section 7 Township 33 Range 11WWell No. #1 FitzgeraldCompany M.B. Armer

NORTH

16

WEST

EAST

							0

SOUTH

Barber

KANSAS

SEC.	TWP.	R.
7	33	11W

WELL NO.

#1 Fitzgerald

FARM

COMPANY

M.B. Armer

CONTRACTOR

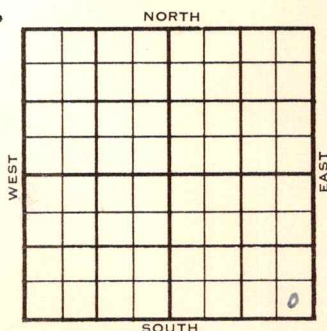
Wildcat.

Ft. from N. Line

330 Ft. from S. Line

330 Ft. from E. Line

Ft. from W. Line

SE SE SE
Sinclair * DHM

	ELEVATION	REPORT
1954	1412'	
10/27	Spud 10-22-54 8" @ 217'	
	Drlg. 2206'	
11/23	Spud 10-22-54 SI Gas Well. TD 4498' 8" @ 217'	
	Doug 3649'	
	DST 3649'-60' opn 1 hr, rec 9,980,000 cfg 90' vhocm 2 gw. 1475#	
	Lans 3760' Miss 4396'	
	DST 4398'-4409' opn 1 hr, rec 30' Mud 200#	
	DST 4425'-62' opn 1 hr, rec 20' mud 50#	
	TD 4500'	
	DST 4472'-4500' opn 1 hr, rec 230' Mud 250#	
	Heeb 3564' Doug 3647', Lans 3743'	
	Miss 4394'	
	TD 4498'	
	5" @ 3805'	
	32/ 3648-56 10,900,000 cfg. 1½ hr. Comp SI Gas Well.	
		COMPLETED

County **Barber** State **Kansas**

Sec. **7** (Blk. **33** (Sur. **11W** Map No.

Operator **M. B. Armer**

Well No. **1** Farm **Fitzgerald**

Elev.		Location	SE SE SE
-------	--	----------	----------

FIRST REPORT

330 Ft. From S Line SE

330 Ft. From **E** Line Quarter

1st. Report OCT 27 1954

Completion

Remarks Sinclair - DEM

Spudding Date 10-22-54

Drig. Data Wildcat

8" @ 217 drlg. 2206

FABEN GILSTRAP

